

Map No. _____ Sec. 7 Twp. 26 R. 5Well No. 11 Anderson FarmEngine Company

NORTH

SOUTH

Location _____

Rig up. ☒ _____

Drilling and remarks:

RECORD

Cased _____ in. _____ Ft.

Sand _____

Gas _____

Oil _____

Total Depth _____

PRODUCTION

1st 24 hrs. Nat. _____

1st 24 hrs. after shot _____

Gas _____ Cu. Ft.

Dry Hole _____

Abandoned _____

Date

2/14, 1919, Condy Scout

Map No. _____ Sec. 7 Twp. 26 R. 5

Well No. 11 Anderson Farm

_____ Company

NORTH

SOUTH

Location _____

Rig up ☒

Drilling and remarks:

RECORD

Cased _____ in. _____ Ft.

Sand _____

Gas _____

Oil _____

Total Depth _____

PRODUCTION

1st 24 hrs. Nat. _____

1st 24 hrs. after shot _____

Gas _____ Cu. Ft.

Dry Hole _____

Abandoned _____

Date


JUL 14 1917

, 191

E. T. Crocker Scout

Map No. _____ Sec. 7 Twp. 26 R. 5
 Well No. 11. Anderson Farm
Empire Company
 NORTH

WEST

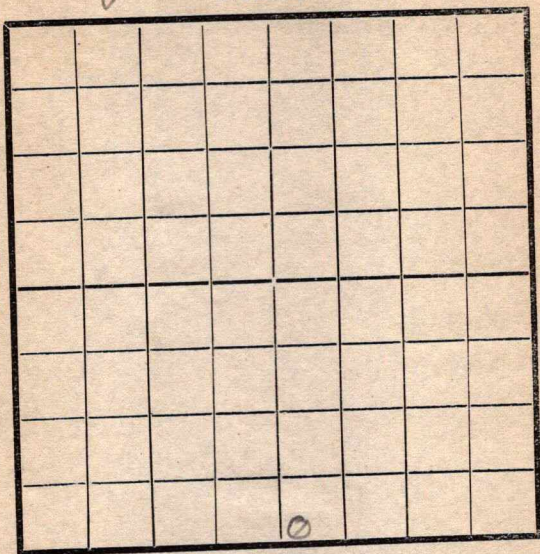

EAST

SOUTH

RECORD

Location _____

Cased _____ in. _____ Ft.

Rig Up _____

Sand _____

Drilling and remarks

Gas _____

Oil _____

Total Depth _____

at 2025.

PRODUCTION

1st 24 hrs. Nat. _____

1st 24 hrs. after shot _____

Gas _____ Cu. Ft.

Dry Hole _____

Abandoned _____

Date


8-23, 1917Lantz

Scout

Map No. _____ Sec. 7 Twp. 26 R. 5Well No. 11 Anderson Farm
Empire Company

NORTH

WEST

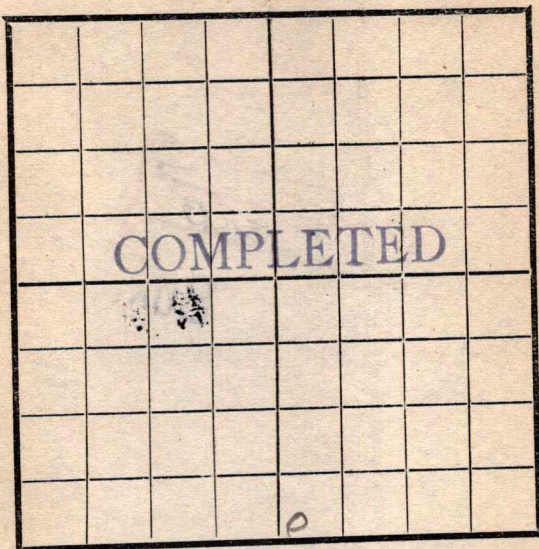

EAST

SOUTH

RECORD

Location _____

Rig Up _____

Drilling and remarks

Cased _____ in. _____ Ft.

Sand 2392 - 2448

Gas _____

Oil _____

Total Depth _____

PRODUCTION

1st 24 hrs. Nat. _____

1st 24 hrs. after shot _____

Gas _____ Cu. Ft.

Dry Hole _____

Abandoned _____

Date

9/5, 1917 Cordiff Scout