


Map No. _____ Sec. 7 Twp. 26 R. 5
Well No. 12 Anderson Farm _____
_____ Empire Company _____
NORTH

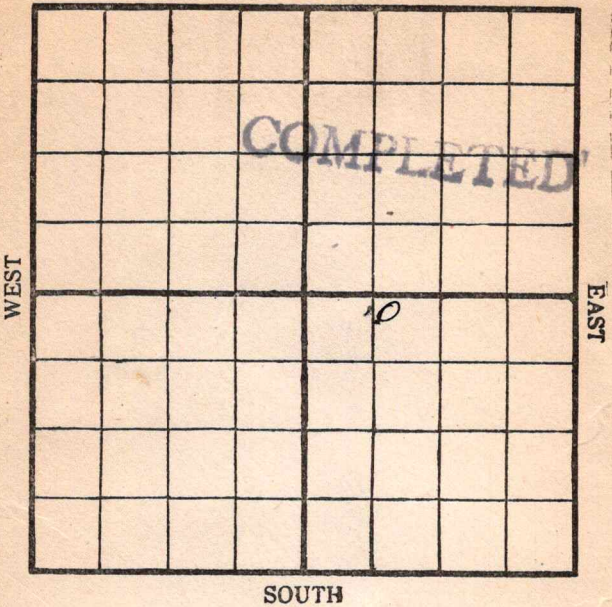

Location _____

Rig Up _____

Drilling Remarks: _____

Drilling Remarks: _____

RECORD

PRODUCTION

Cased _____ in. _____ ft.
Sand _____
Gas _____
Oil _____
Total Depth _____


1st 24 hrs. Nat. _____
1st 24 h.s. after shot _____
Gas _____ cu. ft
Dry Hole _____
Abandoned _____

Map No. _____ Sec. 7 Twp. 26 R. 5
 Well No. 12. Anderson Farm
Empire Company

NORTH

WEST

EAST

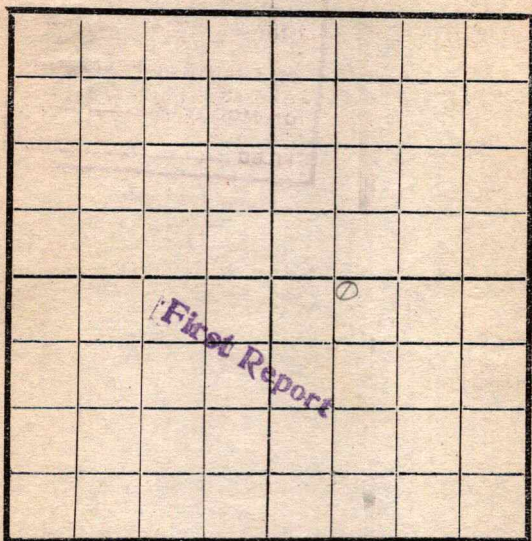

SOUTH

Location _____

Rig Up _____

Drilling and remarks

Shedding

RECORD

Cased _____ in. _____ Ft

Sand _____

Gas _____

Oil _____

Total Depth _____

PRODUCTION

1st 24 hrs. Nat. _____

1st 24 hrs. after shot _____

Gas _____ Cu. Ft.

Dry Hole _____


Abandoned _____

Date

8-29-17, 1917*Lantz* Scout

Map No. _____ Sec. 7 Twp. 26 R. 3Well No. 12 Anderson FarmEmpire Company

NORTH

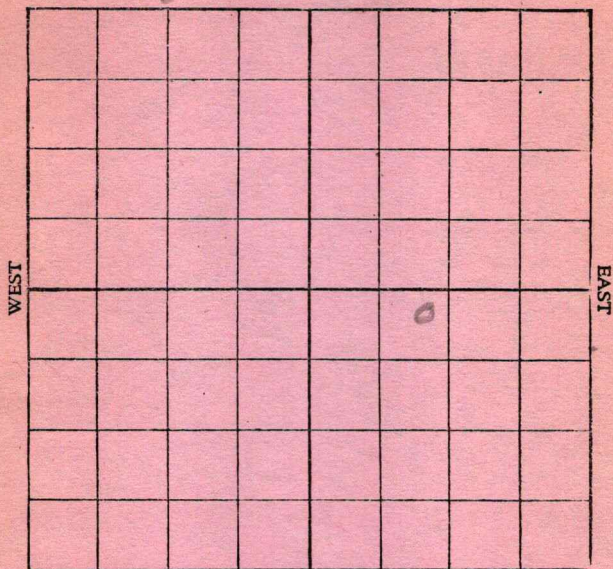

SOUTH

Location _____

Rig up _____

Drilling and remarks:

2370

RECORD

Cased _____ in. _____ Ft.

Sand _____

Gas _____

Oil _____

Total Depth _____

PRODUCTION

1st 24 hrs. Nat. _____

1st 24 hrs. after shot _____

Gas _____ Cu. Ft.

Dry Hole _____

Abandoned _____


Date

10/9, 1917, Curdy Scout

Map No. _____ Sec. 7 Twp. 26 R. 5Well No. 12 Anderson FarmEngine Company

NORTH

WEST

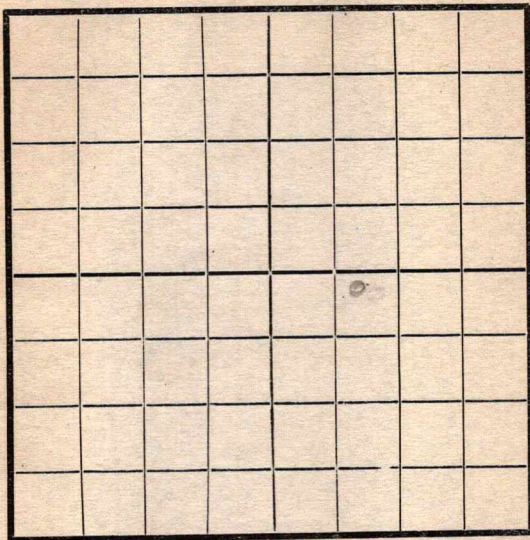

EAST

SOUTH

Location _____

Rig Up _____

Drilling and remarks

Fishing
2370

RECORD

Cased _____ in. _____ Ft.

Sand _____

Gas _____

Oil _____

Total Depth _____

PRODUCTION

1st 24 hrs. Nat. _____

1st 24 hrs. after shot _____

Gas _____ Cu. Ft.

Dry Hole _____

Abandoned _____


Date

10-7, 191*7* *Candoff* Scout

Map No. _____ Sec. 7 Twp. 26 R. 5Well No. 12 Anderson Farm
Engle Company

NORTH

WEST

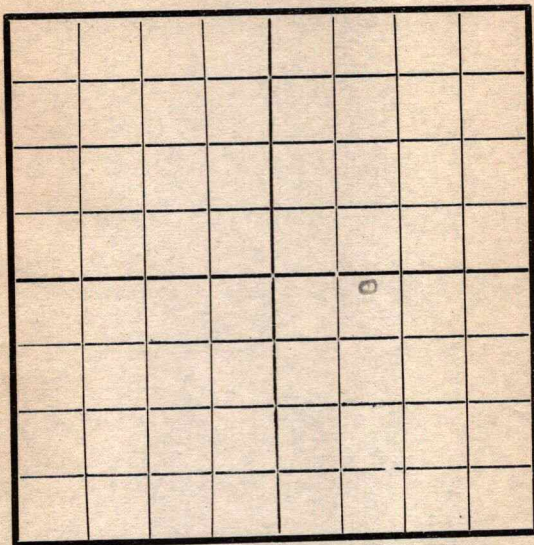

EAST

SOUTH

RECORD

Location _____

Rig Up _____

Drilling and remarks

Cased _____ in. _____ Ft.

Sand _____

Gas _____

Oil _____

Total Depth _____

PRODUCTION

1st 24 hrs. Nat. _____

1st 24 hrs. after shot _____

Gas _____ Cu. Ft.

Dry Hole _____

Abandoned _____


Date

1924, 191 7 Condy Scout

Map No. _____ Sec. 7 Twp. 26 R. 5
 Well No. 12 Anderson Farm
Empire Company

NORTH

WEST

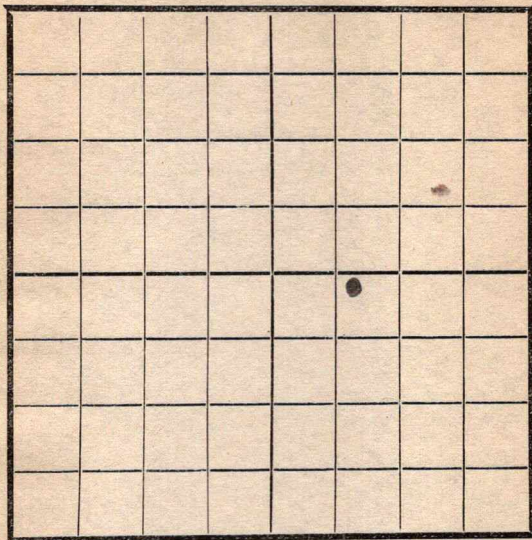

EAST

SOUTH

Location _____
 Rig Up _____
 Drilling and remarks

2. 12. 2370'

RECORD

Cased _____ in. _____ Ft.
 Sand _____
 Gas _____
 Oil _____
 Total Depth _____

PRODUCTION

1st 24 hrs. Nat. _____
 1st 24 hrs. after shot _____
 Gas _____ Cu. Ft.
 Dry Hole _____
 Abandoned _____

Date

10-31, 1917


Pyle

Scout

Map No. _____ Sec. 7 Twp. 26 R. 5
Well No. 12 Anderson Farm _____
Empire Company _____

NORTH

WEST

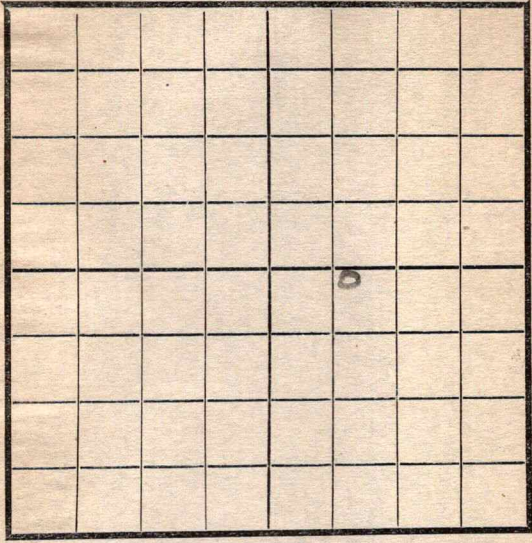

EAST

SOUTH

Location _____
Rig Up _____
Drilling and remarks _____

RECORD
Cased _____ in. _____ Ft.
Sand _____
Gas _____
Oil _____
Total Depth _____


PRODUCTION
1st 24 hrs. Nat. _____
1st 24 hrs. after shot _____
Gas _____ Cu. Ft.
Dry Hole _____
Abandoned _____

Date 1 1/4, 1917 Pyle Scout _____

Map No. _____ Sec. 7 Twp. 26 R. 5
 Well No. 12 Anderson Farm _____
Empire Company _____

NORTH

WEST

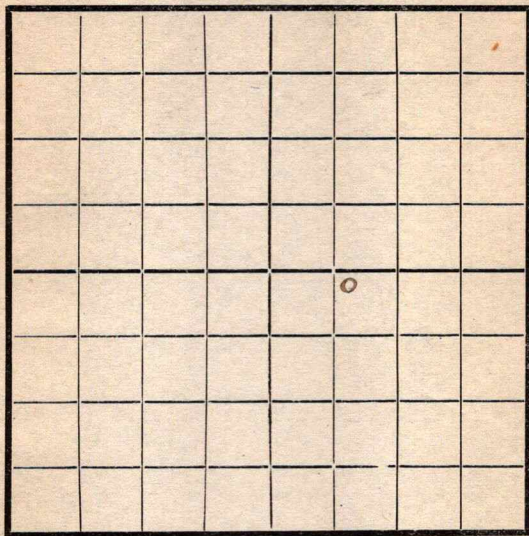

EAST

SOUTH

Location _____

Rig Up _____

Drilling and remarks

RECORD

Cased _____ in _____ Ft.

Sand 2410-2477

Gas _____

Oil _____

Total Depth _____

PRODUCTION

1st 24 hrs. Nat. _____

1st 24 hrs. after shot _____

Gas _____ Cu. Ft.

Dry Hole _____

Abandoned _____

Date

11/14, 1917 Gyle Scout

L1004
 Map No. K14 Sec. 7 Twp. 26 R. 5
 Well No. 12 Andersson Farm
Empire Company

NORTH

WEST

EAST

SOUTH

Location -----
 Rig Up -----
 Drilling and remarks -----

RECORD

Cased ----- in ----- Ft.
 Sand 2410-2477
 Gas -----
 Oil 75 bbls
 Total Depth -----

PRODUCTION

1st 24 hrs. Nat. -----
 1st 24 hrs. after shot -----
 Gas ----- Cu. Ft.
 Dry Hole -----
 Abandoned -----

Date

11/15, 1917 Pyle Sco