

Map No. K 14 Sec. 7 Twp. 26 R. 5

Well No. 13 Anderson Farm

Empire Company

Michaels NORTH Blackburn

							0

SOUTH

WEST

EAST

COMPLETED

Location 5855 + E

Drilling Remarks:

RECORD

Cased _____ in. _____ ft.

Sand 2404 - 2439

Gas _____

Oil _____

Total Depth _____

Rig Up _____

Drilling Remarks:

PRODUCTION

1st 24 hrs. Nat. 45

1st 24 hrs. after shot _____

Gas _____ cu. ft.

Dry Hole _____


Abandoned _____

Map No. K14 Sec. 7 Twp. 26 R. 5
 Well No. 13 Anderson
Empire Company
Michaels & Blackburn Contractor

NORTH

WEST

EAST

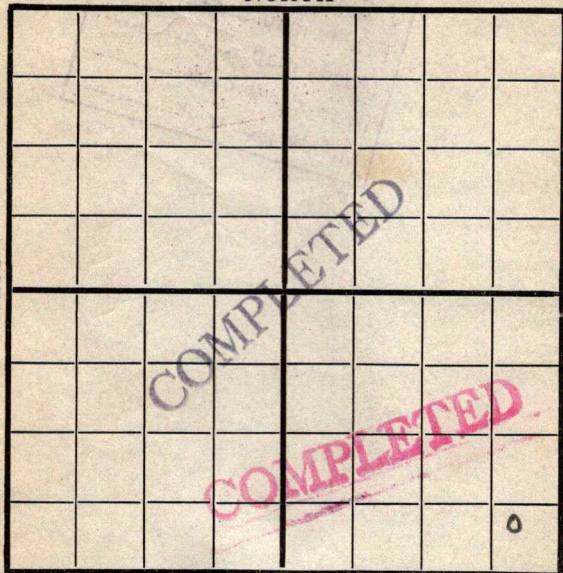

SOUTH

Location 585 10E

Rig up _____

Drilling and Remarks:



RECORD

Cased _____ in., _____ ft.

Sand 2404-2439

Gas _____

Oil _____

Total Depth _____

PRODUCTION

1st 24 hrs. Nat. 45 bbl

1st 24 hrs. after shot _____

Gas _____ Cu. Ft.

Dry Hole _____

Abandoned _____

Date

10/8 191 5 Cycle Scout