FORM 51 25M 8-50 WESTERN


Sedgwick

KANSAS

Section 19 Township 26 Range 2E

Well No. #3 Tjaden

Company J. P. Gatty

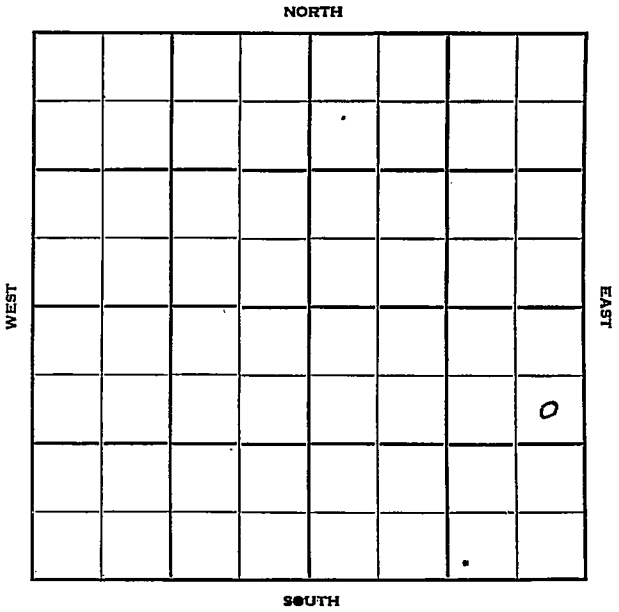

FORM 252-B
10M 10-50 PETROL

Sedgwick KANSAS

Sec. 19 Twp. 26 R. 2E

Well No. #3 Tjaden Farm

J. P. Gatty Company

Morrison Drlg. - Contr. Contractor

Greenwick Pool


990' Ft. from N. Line

Ft. from S. Line

330' Ft. from E. Line

Ft. from W. Line

SE NE SE

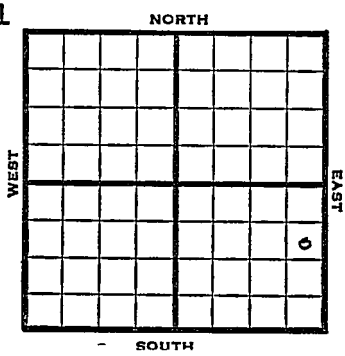

1950	Elev 1384'	REPORT
12/6	Cellar & Pits	
1951		
1/17	Spud 12-8-50 8" @ 107 Burgess 2942 TD 2958 5½" @ 2942 Comp 26 bopd Completed	

COMPLETED

FORM 275 FOR SALE BY KANSAS BLUE PRINT CO.


County Sedgwick State Kansas

Sec. 19 (Blk. Twp.) 26 (Sur. Rge.) 2E Map No.

Operator J. P. Gatty

Well No. 3 Farm Tjaden

Elev. Location SE NE SE

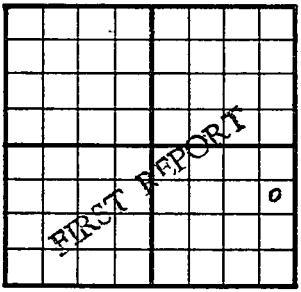

990 Ft. From N Line SE

330 Ft. From E Line Quarter

1st. Report DEC 6 1950

Completion

Remarks Morrison Drlg. - Contr.

Spudding Date

Drlg. Data Greenwick Pool

Cellar & pits

J. E. TYRA

FORM 275 FOR SALE BY KANSAS BLUE PRINT CO.


County Sedgwick State Kansas

Sec. 19 (Blk. Twp.) 2 6 (Sur. Rge.) 2E Map No.

Operator J. P. Gatty

Well No. 3 Farm Tjaden

Elev. 1384 Location SE NE SE

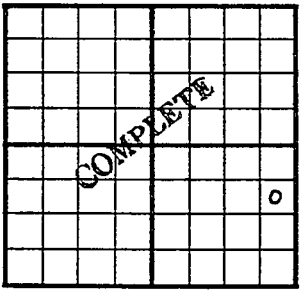

990 Ft. From N Line SE

330 Ft. From E Line Quarter

1st. Report

Completion JAN 17 1951

Remarks Greenwick Pool

Morrison Drlg. - Contr.

Spudding Date 12-8-50

Drlg. Data Oil well TD 2958

8" @ 107 Burgess 2942 TD 2958

5½" @ 2942 Comp. 26 bopd

J. E. TYRA