Sedgwick


FORM 51 10M 7-48 PETROL KANSAS

Section 20 Township 26 Range 2-E

Well No. #1 Sample "B"

Company J P Gatty

Miscellaneous

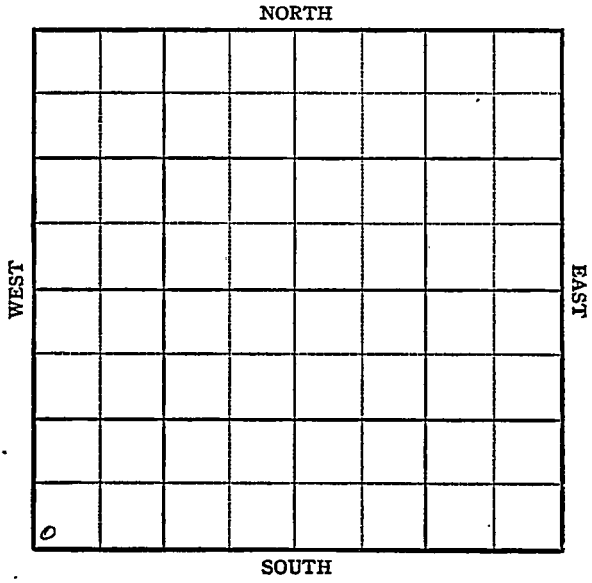

FORM 252-A
5M 10-48 PETROL


Sedgwick KANSAS

Sec. 20 - Twp. 26 R. 2E

Well No. #1 Sample "B" Farm

J. P. Gatty Company

Miscellaneous (Morrison Drlg., Contr.)

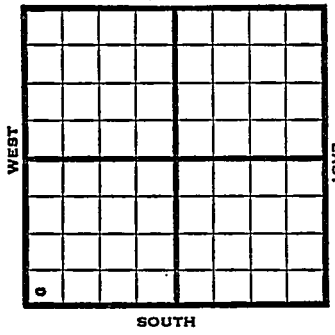

_____ Ft. from N. Line

150' Ft. from S. Line

_____ Ft. from E. Line

150' Ft. from W. Line

SW/C

1949	Elev 1388' REPORT
11/30	8" @ 123' Drlg. 350'
12/7	KC 2551' Drlg 2760'
12/14	5" @ 2936' Burgess 2937 TD 2939' 2000'oil 3 hrs.
12/21	"
12/28	"
1950 1/11	TD 2939' 8"@ 123' 5"@ 2936' KC 2551' Burgess 2937' PP 132 BOPD Comp

COMPLETED

Form 26 200 Bks. 6-49 Petrol

Kansas

Miscellaneous

Map No. ____ Sec. 20 Twp. 26 R. 2E

Well No. 1 Sample "B"


J. P. Gatty Company

Morrison Drlg. Contractor

FIRST REPORT

SW/C

SECTION PLAT

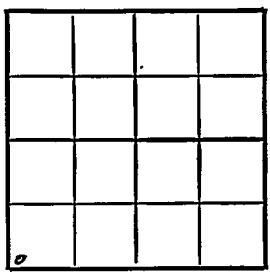

____ Ft. from N. Line

150 Ft. from S. Line

____ Ft. from E. Line

150 Ft. from W. Line

Sedgwick County

Location

Rig up

Drilling and Remarks:

8" @ 123

drlg. 350

RECORD

Cased ____ in., ____ ft.

Sand

Gas

Oil

Total Depth

PRODUCTION

1st 24 hrs. Nat.

1st 24 hrs. after shot

Gas ____ Cu. Ft.

Dry Hole

Abandoned

Date

NOV 30 1949 19 S. J. LEWIS Scout

Form 26 200 Bks. 6-49 Petrol Kansas Miscellaneous

Map No. Sec. 20 Twp. 26 R. 2E

Well No. 1 Sample "B"


J. P. Gatty Company

Contractor

SW/C

Elv. 1388

SECTION PLAT

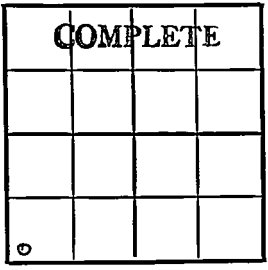

Ft. from N. Line

150 Ft. from S. Line

Ft. from E. Line

150 Ft. from W. Line

Sedgwick County

Location

Rig up

Drilling and Remarks:

8" @ 123

5" @ 2936

K.C. 2551

Burgess 2937

PP 132 BOPD

RECORD

Cased in., ft.

Sand

Gas

Oil

Total Depth 2939

PRODUCTION

1st 24 hrs. Nat.

1st 24 hrs. after shot

Gas Cu. Ft.

Dry Hole

Abandoned

Date

JAN 11 1950

19

J. E. TYRA Scout