

Section 20 Township 26 Range 2 EWell No. #2 Sample "B"Company J. P. Gatty

NORTH

0							

WEST

EAST

SOUTH

Sedgwick

KANSAS

Sec. 20 Twp. 26 R. 2E

Well No. #2 Sample "B" Farm

J. P. Gatty Company

Howell - Contr. Contractor

White Cotton Pool


 Ft. from N. Line

990' Ft. from S. Line

 Ft. from E. Line

330' Ft. from W. Line

NW SW SW

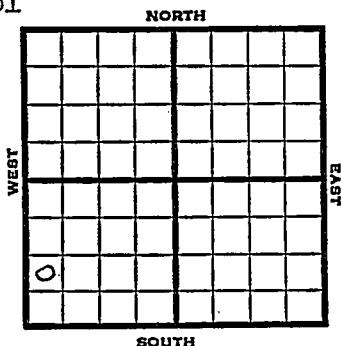

1951 Elev. 1382' REPORT

1/31 Drlg. 1200'

3/21 Spud 1-24-51 Oil well TD 2934'
8" @ 108', KC 2500', Burgess 2932'
TD 2934', 5" @ 2933' FU 2400' oil
Comp. 28 bopd

COMPLETED

J. E. TYRA

County Sedgwick State KansasSec. 20 (Blk.
Twp.) 26 (Sur.
Rge.) 2E Map No.Operator J. P. GattyWell No. 2 Farm Sample "B"Elev. 1382 Location NW SW SW

0							

990 Ft. From S Line SW330 Ft. From W Line QuarterIst. ReportCompletion MAR 21 1951Remarks White Cotton PoolHowell - Contr.Spudding Date 1-24-51Drig. Data Oil well TD 29348" @ 108 KC 2500 Burgess 2932TD 2934 5" @ 2933 FU 2400' oilComp. 28 bopd

J. E. TYRA