
FORM 51 25M 8-50 WESTERN

Sedgwick KANSAS

Section 20 Township 26 Range 2E

Well No. #1 Erdwin (Erdwein)

Company L. McLaughlin

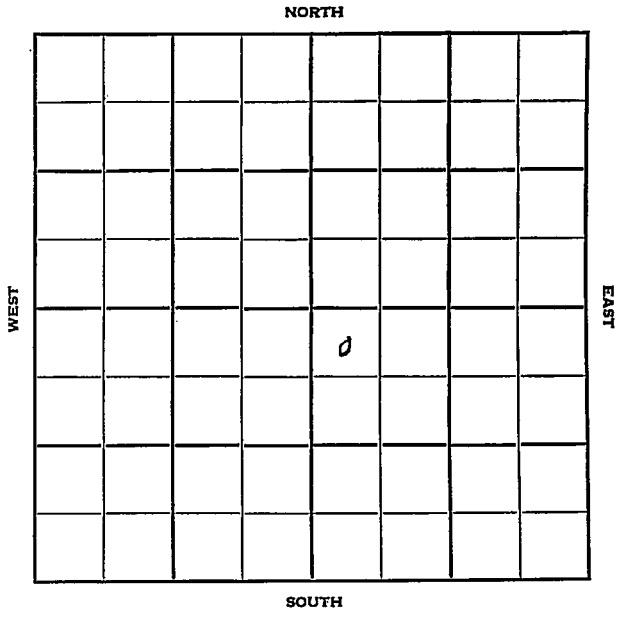

FORM 252-B
10M 11-50 PETROL

Sedgwick KANSAS

Sec. 20 Twp. 26 R. 2 E

Well No. # 1 Erdwin Farm

L. McLaughlin Company

Allison Contractor

Wildcat


330 Ft. from N. Line

Ft. from S. Line

Ft. from E. Line

330 Ft. from W. Line

NW NW SE

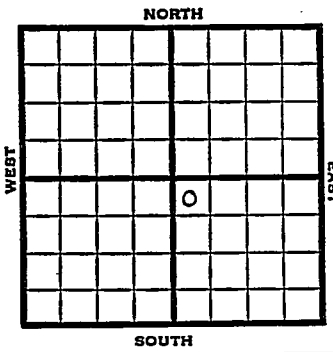

1951	Elev. 1398' REPORT
4/4	R U R
4/18	Spud 4-3-51 D&A TD 2999 8" @ 85 KC 2505 Miss 2953 DST 2954-59 opn ½ hr Rec. 5' mud TD 2999' D&A
	ABANDONED

FORM 275 FOR SALE BY KANSAS BLUE PRINT CO.


County Sedgwick State Kansas

Sec. 20 (Blk. / Twp.) 26 (Sur. / Rge.) 2E Map No.

Operator L. McLaughlin

Well No. 1 Farm Erdwin

Elev. Location NW NW SE

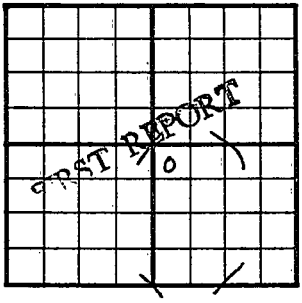

330 Ft. From N Line SE

330 Ft. From W Line Quarter

1st. Report APR 4 1951

Completion

Remarks

Allison - Contr.

Spudding Date

Drlg. Data Wildcat

R U R

J. E. TYRA

FORM 275 FOR SALE BY KANSAS BLUE PRINT CO.


County Sedgwick State Kansas

Sec. 20 (Blk. Twp.) 26 (Sur. Rge.) 2E Map No.

Operator L. McLaughlin

Well No. 1 Farm Erdwin

Elev. 1398 Location NW NW SE

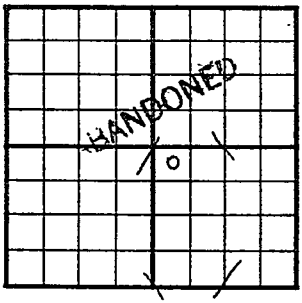

330 Ft. From N Line SE

330 Ft. From W Line Quarter

1st. Report

Completion APR 18 1951

Remarks Wildcat

Allison - Contr.

Spudding Date 4-3-51

Drlg. Data D & A TD 2999

8" @ 85 KC 2505 Miss. 2953

DST 2954-59 open ½ hr. Rec. 5' mud

TD 2999 D & A

J. E. TYRA