


Map No. _____ Sec. 7 Twp. 26 R. 5
 Well No. 14 Anderson Farm
Empire Company

NORTH

WEST

EAST

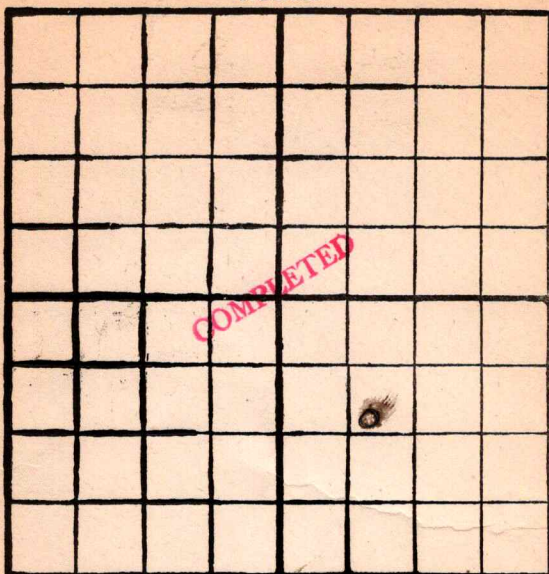

SOUTH

Location _____

Rig Up _____

Drilling Remarks:

Drilling Remarks:

RECORD

PRODUCTION

Cased _____ in. _____ ft.

1st 24 hrs. Nat. _____

Sand _____

1st 24 hrs. after shot _____

Gas _____

Gas _____ cu. ft.

Oil _____

Dry Hole _____

Total Depth _____

Abandoned _____

Map No. K14 Sec. 7 Twp. 26 R. 5
 Well No. 14 Andersson
Empire _____ Company
 _____ Contractor

NORTH

WEST

EAST

COMPLETED

SOUTH

1537 S

772 W

Location _____

Rig up _____

Drilling and Remarks:

RECORD

Cased _____ in., _____ ft.

Sand 2414 - 2450

Gas _____

Oil _____

Total Depth _____

PRODUCTION

1st 24 hrs. Nat. 40 bbl

1st 24 hrs. after shot _____

Gas _____ Cu. Ft.

Dry Hole _____

Abandoned _____

Date

5/20

1919

C. J. K.

Scout