


Map No. KANSAS Sec. 21 Twp. 26 R. 5^E
 Well No. 66-Koogler Farm
Magnolia Pet Company

NORTH

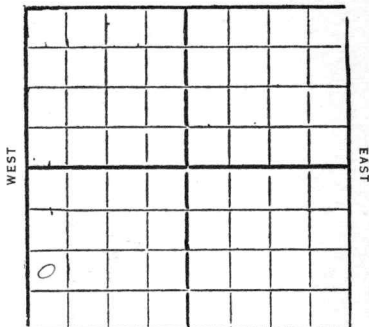

SOUTH

_____ Ft. from N. Line

990 Ft. from S. Line

_____ Ft. from E. Line

330 Ft. from W. Line

1931

Date

REPORT

4/15	Reg
4/22	Spdg
4/29	Dreg 680'
5/6	" 1120'
5/13	" 1930'
5/20	" 2330'
5/27	Stk 6"-2490'
6/3	Top Viola 2535
	Mulcox 2590-2625
	shot 100 qt
	Clog out
6/10	Had 600' water in hole after shot
	Dreg 2650'
6/17	Top Viola 2535
	" Mulcox 2590
	HFV 2675-90
	TD 2690
	Dry & Abandon

Butler

E

14 KANSAS Map No. Sec. 21 Twp. 26 R. 5

Well No. 66 Hoagler
 Magnolia Petroleum Co. Company
 Contractor

FIRST REPORTS

Ft. from N. Line

990 Ft. from S. Line

Ft. from E. Line

330 Ft. from W. Line

SECTION PLAT

0			

Location

Rig up ✓

Drilling and Remarks:

RECORD

Cased in., ft.

Sand

Gas

Oil

Total Depth

PRODUCTION

1st 24 hrs. Nat.

1st 24 hrs. after shot

Gas Cu. Ft.

Dry Hole

Abandoned

Date

APR 15 1931

192

CHAS. L. SHERWOOD

Scout

14 KANSAS

Map No. _____ Sec. 21 Twp. 26 R. 5 ^EWell No. 66 KresglerMagnolia Petroleum Co Company_____
Contractor

COMPLETE

SECTION PLAT

Ft. from N. Line990 Ft. from S. Line_____
Ft. from E. Line330 Ft. from W. Line

ABANDONED

0			

Location _____

Rig up _____

Drilling and Remarks:

Top Viola 7535" Wilcox 7590HFV 7675-90'D+9 7690

RECORD

Cased _____ in., _____ ft.

Sand _____

Gas _____

Oil _____

Total Depth 7690

PRODUCTION

1st 24 hrs. Nat. _____

1st 24 hrs. after shot _____

Gas _____ Cu. Ft.

Dry Hole ☒Abandoned ☒

Date

JUN 17 1931

CHAS. L. SHERWOOD

192

Scout