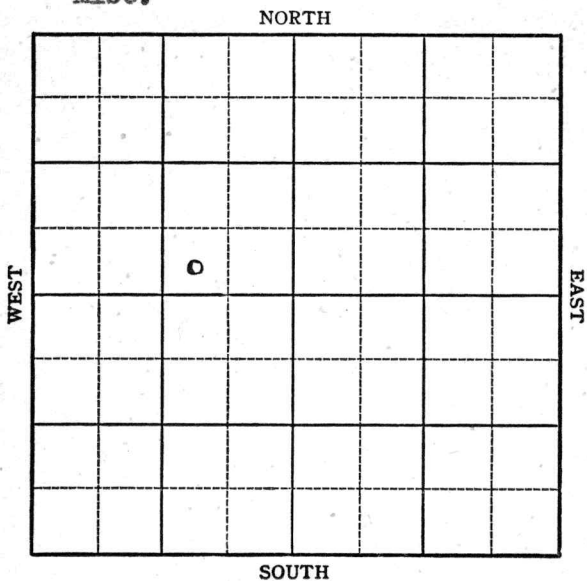


KANSAS

Butler


Section 21 Township 26 Range 5EWell No. 77 Kogler (*Kogler*)Company Magnolia
Misc.

KANSAS

Butler ✓

Sec. 21 Twp. 26 R. 5-EWell No. #77 Kogler Farm
Magnolia Company

 Ft. from N. Line
330 Ft. from S. Line
990 Ft. from E. Line
 Ft. from W. Line

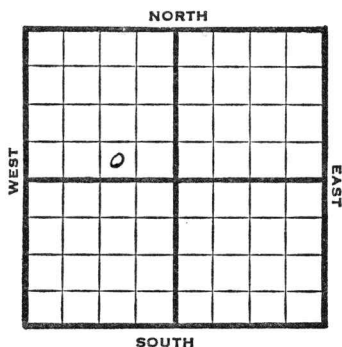

SW SE NW

1947

REPORT

4/9 Machine

4/15 13" @ 300'
Drlg. 769'

4/23 SD

4/29 Drlg 1200'

5/7 Drlg. 1711'
8" @ 1190'5/13 7" @ 2062'
Drlg 2145'5/20 Viola 2530-32
TD 3532'
5" @ 2518'
WOC

5/27 " "

6/3 5" @ 2530 corrected
TD 2547-250 acid
30 qts 2535-47 CO

OVER


6/11 Viola 2530'
5" @ 2530'
30 Qts. 2535-47'
250 Acid
Pump 25 Pot
38.0 Gr.
TD 2547'

COMPLETED

Map No. K14 Sec. 21 Twp. 26 R. 5EWell No. 77 KoglerMagnolia CompanyFIRST REPORT Contractor

SW SE NW

SECTION PLAT

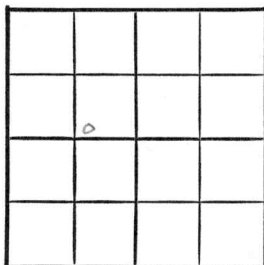 Ft. from N. Line330 Ft. from S. Line990 Ft. from E. Line Ft. from W. LineButler CountyLocation Rig up

Drilling and Remarks:

Machine

RECORD

Cased in., ft.Sand Gas Oil Total Depth

PRODUCTION

1st 24 hrs. Nat. 1st 24 hrs. after shot Gas Cu. Ft.Dry Hole Abandoned

Date

APR 9 1947 19S. J. LEWIS Scout

Map No. 14 Sec. 21 Twp. 26 R. 5E

Well No. 77 Koegler

Magnolia Company

COMPLETE Contractor

SW SE NW


SECTION PLAT

 Ft. from N. Line

330 Ft. from S. Line

990 Ft. from E. Line

 Ft. from W. Line

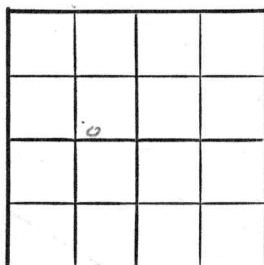

Butler County

Location

Rig up

Drilling and Remarks:

Viola 2030
5' to 2030
30 ft 2035-47
2000 oil
Pump 2030
380 ft

RECORD

Cased in., ft.

Sand

Gas

Oil

Total Depth 2047

PRODUCTION

1st 24 hrs. Nat.

1st 24 hrs. after shot

Gas Cu. Ft.

Dry Hole

Abandoned

Date

JUN 11 1947 19

S. J. LEWIS Scout