


Map No. KANSAS Sec. 21 Twp. 26 R. 5E
Well No. 64-Boogler Farm
Magnolia Pet Company

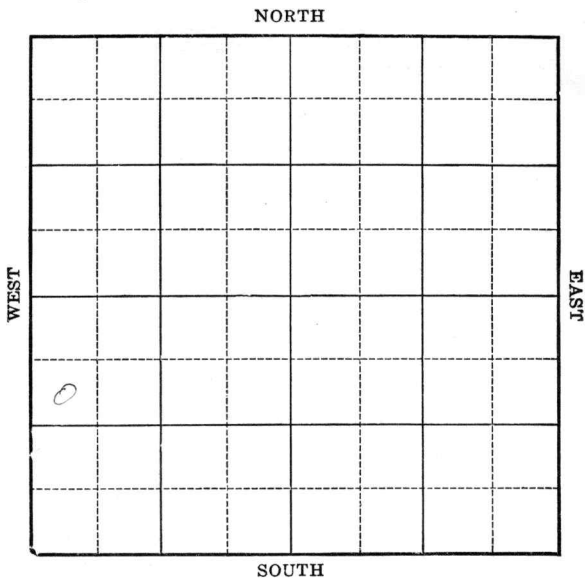

Location _____
Drilling Remarks _____

Rig Up _____
Drilling Remarks _____

RECORD


Cased _____ in. _____ ft.
Sand _____
Gas _____
Oil _____
Total Depth _____

PRODUCTION

1st 24 hrs. Nat. _____
1st 24 hrs. after shot _____
Gas _____ cu. ft. _____
Dry Hole _____
Abandoned _____

Map No. KANSAS Sec. 21 Twp. 26 R. 5^E
Well No. 64 - Hoogler Farm
Magnolia Pet Company

NORTH

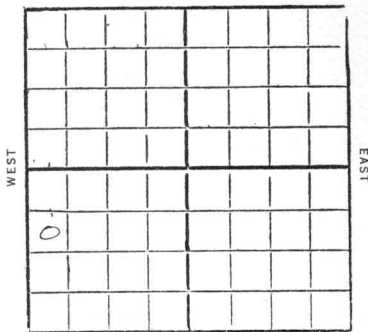

990 Ft. from N. Line

_____ Ft. from S. Line

_____ Ft. from E. Line

330 Ft. from W. Line

1930

SOUTH

Date

REPORT

12/17	Bldy reg
12/23	Spdy 250
12/30	dry 300'
1931	
1/7	" 1200
1/14	10" 1768
1/21	dry 1780'
1/28	" 2330
2/4	" 2528'
	Sand 2507-09
	T.D. 2509
	Made 150 bbl oil
	Comp.

KANSAS

Map No. 14 Sec. 21 Twp. 26 R. 5Well No. 64Company ButlerContractor Koupler

FIRST REPORTS

990 Ft. from N. Line

Ft. from S. Line

Ft. from E. Line

320 Ft. from W. Line

SECTION PLAT

0			

Location

Rig up

Drilling and Remarks:

Blow Rig

RECORD

Cased in., ft.

Sand

Gas

Oil

Total Depth

PRODUCTION

1st 24 hrs. Nat.

1st 24 hrs. after shot

Gas Cu. Ft.

Dry Hole

Abandoned

Date

DEC 17 1930

192

CHAS. L. SHERWOOD

Scout

Map No. **KANSAS** Sec. **21** Twp. **26** R. **5E**

Well No. **64 Hoogler**

Magnolia P. & S. Company

Contractor

SECTION PLAT

990 Ft. from N. Line

Ft. from S. Line

Ft. from E. Line

830 Ft. from W. Line

COMPLETED

Location

Rig up

Drilling and Remarks:

10088h.

RECORD

Cased in, ft.

Sand **2507 - 09**

Gas

Oil

Total Depth **2509**

PRODUCTION

1st 24 hrs. Nat.

1st 24 hrs. after shot

Gas Cu. Ft.

Dry Hole

Abandoned

Date

FEB 4 1931 **S. J. LEWIS** Scout