


Map No. _____ Sec. 20 Twp. 26 R. 2
 Well No. 1 Glader Farm
J. C. Coffman & Co. Company

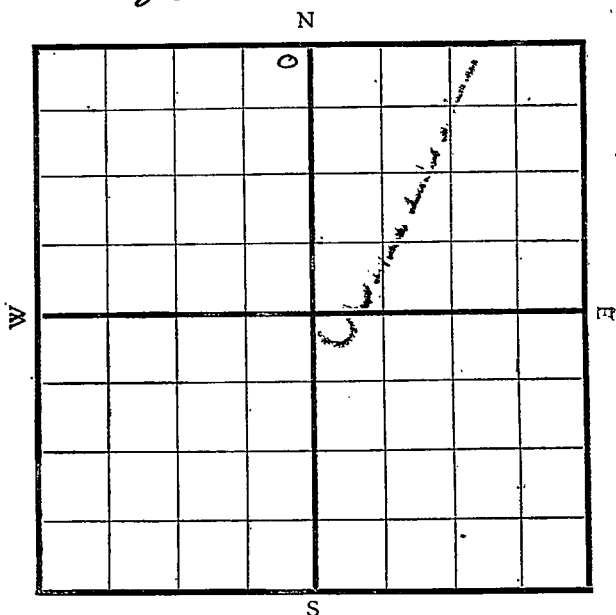

Location _____

Drilling Remarks:

Rig Up _____

Drilling Remarks:

RECORD

Cased _____ in. _____ ft.

Sand _____

Gas _____

Oil _____

Total Depth _____

PRODUCTION

1st 24 hrs. Nat. _____

1st 24 hrs. after shot _____

Gas _____ cu. ft.

Dry Hole _____

Abandoned _____

Map No. _____ Sec. 20 Twp. 26 R. 2


Well No. 1. Lader Farm

J. C. Coffman et al Company

200 Ft. from N. Line

_____ Ft. from, S. Line

200 Ft. from E. Line

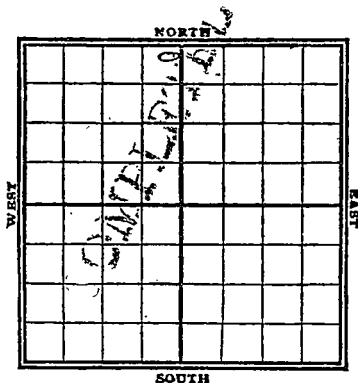Ft. from W₂ Line

Date 7/9/30

REPORT **FIRST** REPO-

2/7 By sup.

124 King

16	Rt
----	----

23	RLg
----	-----

317	
-----	---

13	14
----	----

4/3	1
-----	---

24	✓
25	

29	✓
16	✓

5/3	2

31	✓
4/2	✓

7/13	PR
------	----

11/5	Very good
------	-----------

Map No. K13 Sec. 20 Twp. 26 R. 2Well No. 1 TjadenJ. C. Coffman et al Company

Contractor

SECTION PLAT

200 Ft. from N. Line

Ft. from S. Line

200 Ft. from E. Line

Ft. from W. Line

	0		

FIRST REPORT

Location

Rig up ☒

Drilling and Remarks:

RECORD

Cased _____ in., _____ ft.

Sand _____

Gas _____

Oil _____

Total Depth _____

PRODUCTION

1st 24 hrs. Nat. _____

1st 24 hrs. after shot _____

Gas _____ Cu. Ft.

Dry Hole _____

Abandoned _____

Date

Feb 7 1920

Pyle

Scout

Map No. K13 Sec. 20 Twp. 26 R. 2Well No. 1 TadenJ. C. Coffman et al Company

Contractor

SECTION PLAT

200 Ft. from N. Line

Ft. from S. Line

100 Ft. from E. Line

Ft. from W. Line

		0	

COMPLETED

Location

Rig up

Drilling and Remarks:

Rig down

RECORD

Cased _____ in., _____ ft.

Sand _____

Gas _____

Oil _____

Total Depth _____

PRODUCTION

1st 24 hrs. Nat. _____

1st 24 hrs. after shot _____

Gas _____ Cu. Ft.

Dry Hole _____

Abandoned _____

Date

7/13 1920

Pyle

Scout