


KANSAS

Section 21 Township 26 Range 5-E

Well No. 76 Koegler

Company Magnolia

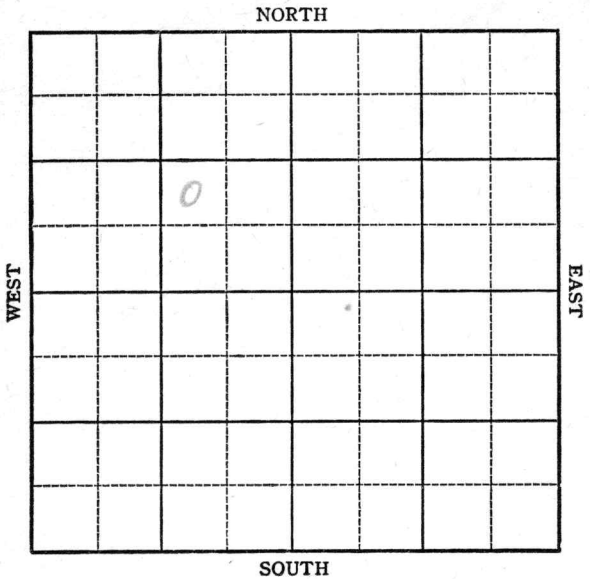


Sec. 21 Twp. 26 R. 5-EWell No. #76 Koegler FarmMagnolia Company

Miscellaneous

Ft. from N. Line

990 Ft. from S. Line990 Ft. from E. Line

Ft. from W. Line

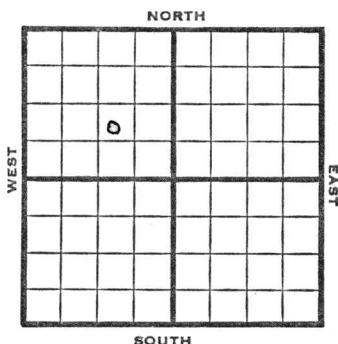

NW SE NW

REPORT

1947

1/29	Spud
2/5	13" @ 327'
2/12	919 fishing
2/19	" "
2/26	Skid Rig 25' west 13" @ 35' Drlg 650'
3/4	10" @ 652' 8" @ 931' Drlg 1430'
3/11	Drlg 2005'
3/18	7" @ 2008 Drlg 2491'
3/25	Viola 2511 -17 TD 2517' 5" @ 2509' RUST
4/2	TD 2529 250 acid Pump 26 bbrs oil in 24 hrs.

OVER

4/9

Viola 2511
5" @ 2509'
250 Acid
Pump 26 Pot
Grav. 38
TD 2592'

COMPLETED

Map No. 14 Sec. 21 Twp. 26 R. 5E

Well No. 76 Koegler

Magnolia Company

FIRST REPORT

Contractor

NW SE NW

SECTION PLAT

	o		

 Ft. from N. Line

990 Ft. from S. Line

990 Ft. from E. Line

 Ft. from W. Line

Butler County

Location

Rig up

Drilling and Remarks:

Spud

RECORD

Cased in., ft.

Sand

Gas

Oil

Total Depth

PRODUCTION

1st 24 hrs. Nat.

1st 24 hrs. after shot

Gas Cu. Ft.

Dry Hole

Abandoned

Date

JAN 29 1947 19

S. J. LEWIS Scout

Map No. K14 Sec. 21 Twp. 26 R. 5EWell No. 76 KoeglerMagnolia Company**COMPLETE**

Contractor

NW SE NW

SECTION PLAT

	△		

 Ft. from N. Line990 Ft. from S. Line990 Ft. from E. Line Ft. from W. Line

Butler County

Location Rig up

Drilling and Remarks:

Vista 2511
5' @ 2509
25000 oil
Pump 26 Bx

25000

RECORD

Cased in., ft.Sand Gas Oil Total Depth 2522

PRODUCTION

1st 24 hrs. Nat. 1st 24 hrs. after shot Gas Cu. Ft.Dry Hole Abandoned

Date

APR 9 1947 19S. J. LEWIS

Scout