

Map No. KANSAS Sec. 22 Twp. 26 R. 2E
Well No. 1-Rapp Farm
Barnsdall Oil Company


259 Ft. from N. Line

_____ Ft. from S. Line

_____ Ft. from E. Line

990 Ft. from W. Line

1929

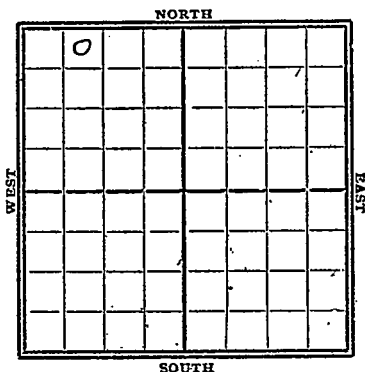

Date

REPORT

6/26	Reg (Notary)
6/26	
7/2	Rig up
7/10	Drily 1460'
7/17	" 2440'
7/24	set 8 1/4" - 2910'
	Chat 2915-23'
	show oil
7/29	2nd Chat 2915'
	T.D. 2923'
	Swab 105 hbls 12 hrs
	show water - will pump
7/31	Oil 2920-28
	Swab 105 hbls 10 hrs
	show water
8/7	sand 2920-28
	T.D. 2928
	100 bbl oil
	Comp.
1929	OWDD
9/11	Drily 2940'

9/18 - Rign up

9/25 - Simpson 3280-90
no show

10/2 - Wrlg up bailer 3290

10/9 - S.D. 3378' TD.

10/16 - T.D. 3378'

Dry & Abandoned

Map No. **KANSAS** Sec. 22 Twp. 26 R. 2E
 Well No. 1 Ray

Barus Oil Company

Contractor

SECTION PLAT


259 Ft. from N. Line

..... Ft. from S. Line

..... Ft. from E. Line

990 Ft. from W. Line

FIRST REPORTS

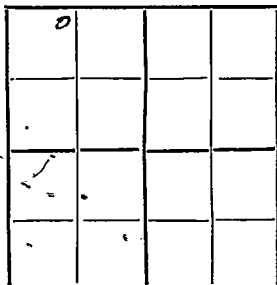

Location.....

Rig up.....

Drilling and Remarks: .

*Rig
Rotary*

RECORD

Cased.....in.,ft.

Sand.....

Gas.....

Oil.....

Total Depth.....

PRODUCTION

1st 24 hrs. Nat.....

1st 24 hrs. after shot.....

Gas.....Cu. Ft.

Dry Hole.....

Abandoned.....

Date

JUN 26 1939 S. J. LEWIS Scout

13 KANSAS

Map No. _____ Sec. 22 Twp. 26 R. 2 E

Well No. 1 Rapp

Barnsdall Oil Company

Contractor _____

COMPLETE

SECTION PLAT

0			

259 Ft. from N. Line

_____ Ft. from S. Line

_____ Ft. from E. Line

990 Ft. from W. Line

Location _____

Rig up _____

Drilling and Remarks:

100 lbs.

RECORD

Cased _____ in., _____ ft.

Sand 2920-2928

Gas _____

Oil _____

Total Depth 2928

PRODUCTION

1st 24 hrs. Nat. _____

1st 24 hrs. after shot _____

Gas _____ Cu. Ft.

Dry Hole _____

Abandoned _____

Date
AUG 7 1929

CHAS. L. SHERWOOD

19

Scout

Belgwich

Map No. KANSAS Sec. 22 Twp. 26 R. 2E

Well No. 1 Rapp

Barnett Oil Company

Contractor

SECTION PLAT

257 Ft. from N. Line

Ft. from S. Line

Ft. from E. Line

990 Ft. from W. Line

0			

OWN

Location

Rig up

Drilling and Remarks:

Dec 29 40

RECORD

Cased in., ft.

Sand

Gas

Oil

Total Depth

PRODUCTION

1st 24 hrs. Nat.

1st 24 hrs. after shot

Gas Cu. Ft.

Dry Hole

Abandoned

Date

SEP 1 1 1929

192

S. J. LEWIS

Scout


Well No. 1 Raff

Barnes Oil Company

Contractor

SECTION PLAT

259 Ft. from N. Line

..... Ft. from S. Line

..... Ft. from E. Line

990 Ft. from W. Line

0			

ABANDONED

Location.....

Rig up.....

Drilling and Remarks:

RECORD

Cased.....in.,ft.

Sand.....

Gas.....

Oil.....

Total Depth 3278

PRODUCTION

1st 24 hrs. Nat.....

1st 24 hrs. after shot.....

Gas.....Cu. Ft.

Dry Hole.....

Abandoned.....

Date

OCT 16 1929

192

S. J. LEWIS Scout