
FORM-3154-M-6-21-PETROL

Sedgwick

Map No. KANSAS Sec. 22 Twp. 26 R. 2E

Well No. 2 Rapp Farm

~~Graham Bros & Robinson~~ Company

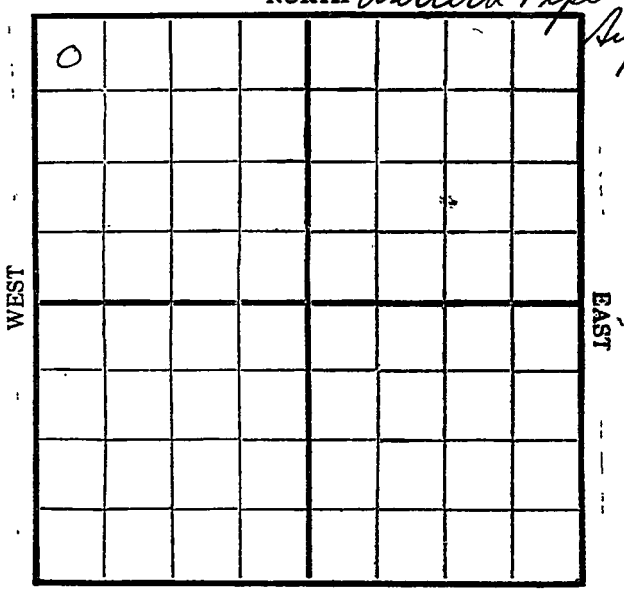

Location #1

Drilling Remarks

Rig Up

Drilling Remarks

RECORD

Cased ____ in: ____ ft.

Sand ____

Gas ____

Oil ____

Total Depth ____

PRODUCTION

1st 24 hrs. Nat. ____

1st 24 hrs. after shot ____

Gas ____ cu. ft.

Dry Hole ____

Abandoned ____

Sedgwick

FORM 252A-5M-12-28-PETROL

Map No. KANSAS Sec. 22 Twp. 26 R. 2E

Well No. 2 Rapp Farm

~~Graham Bros & Barnsdall~~ Company


Western Pipe & Supply

330 Ft. from N. Line

_____ Ft. from S. Line

_____ Ft. from E. Line

330 Ft. from W. Line

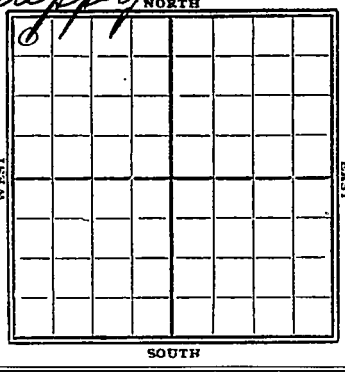

1929

Date	REPORT O. W. D. D
12/11	Timbers
12/11	Rod
12/18	Rig
12/23	Rig
12/30	Rig
1930	
1/8	Rig up
1/15	S.D.
1/22	—
1/29	—
2/5	Spud
2/12	Spud 140'
2/19	Drlg 1000
2/26	" 1485.
3/5	" 1850'
3/12	" 2010
3/19	2785' - Drlg by bit.
3/26	Drlg 2885
4/2	Topped Chat 2938
	T.D. 2941 2" R 5"
4/9	T.D. 2941 Will put on pump.

4/16- T. D. 2941 - Will put on pump.

4/23- No test - T. D. 2941

4/30- T. D. 2955' Swab 70 bbls oil 500 bbls water

5/7- —

5/14- Chat 2938-55 TD 2955 Made 63 bbl oil and 500 " water Comp.

1936

O. W. D. D

4/1- C.O. to deepen

4/10--4/16--

4/23-S.D.

4/30--5/21--5/28--

6/10/36-Did not drill deeper.
Total depth 2960'.
D & A
ABANDONED

Form 2c—1M Blks.—9-28.

Coalgate

Map No. KANSAS Sec. 22 Twp. 26 R. 2 E


15

Well No. 2 Rapp

Graham Bros & Barnes Company

Contractor

SECTION PLAT

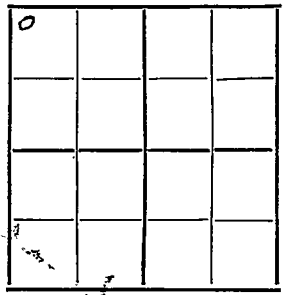

330 Ft. from N. Line

Ft. from S. Line

Ft. from E. Line

330 Ft. from W. Line

FIRST REPORTS

Location

Rig up

Drilling and Remarks:

Tim Fees

RECORD

Cased in., ft.

Sand

Gas

Oil

Total Depth

PRODUCTION

1st 24 hrs. Nat.

1st 24 hrs. after shot

Gas Cu. Ft.

Dry Hole

Abandoned

Date

DEC 1 1 1929

192

S. J. LEWIS Scout

Form 26—1M Bks—9-26-28

Eagle-Picher

Map No. KANSAS Sec. 22 Twp. 26 R. 22E


13

Well No. 2 Ralph

Graham Bros. & Barnsdall Company

Contractor

SECTION PLAT

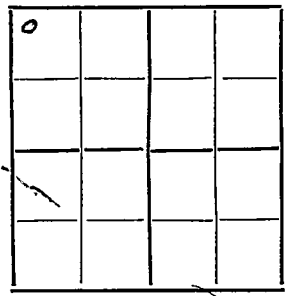

220 Ft. from N. Line

Ft. from S. Line

Ft. from E. Line

460 Ft. from W. Line

COMPLETED

Location

Rig up

Drilling and Remarks:

Cha 82938-55

688 ft shot 6 500 BW

water

RECORD

Cased in., ft.

Sand

Gas

Oil

Total Depth 2905

PRODUCTION

1st 24 hrs. Nat.

1st 24 hrs. after shot

Gas Cu. Ft.

Dry Hole

Abandoned

Date

MAY 14 1930

S. J. LEWIS Scout

Form 26—1M Bks—9-28 KANSAS

Map No. 13 Sec. 22 Twp. 26 R. 2E

Well No. 2 - Rapp

Western Pipe & Supply Company

Contractor

FIRST REPORTS

330 Ft. from N. Line


Ft. from S. Line

Ft. from E. Line

330 Ft. from W. Line

Owdd

SECTION PLAT

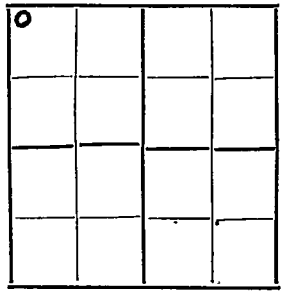

Location

Rig up

Drilling and Remarks:

OTD 2955

C.O.

CORRECTION

Company Name

RECORD

Cased in., ft.

Sand

Gas

Oil

Total Depth

PRODUCTION

1st 24 hrs. Nat.

1st 24 hrs. after shot

Gas Cu. Ft.

Dry Hole

Abandoned

Date

4-1-35 192

ORVAL MANNSCHRECK Scout

Form 26—1M Bks.—2-29

Sedgwick 13


Map No. KANSAS Sec. 22 Twp. 26 R. 2 E

Well No. 2 Ralph

Western Pipe & Supply Company

Contractor

SECTION PLAT

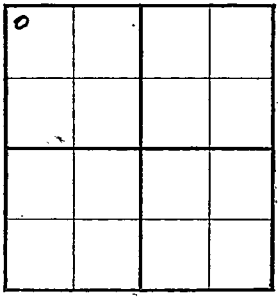

330 Ft. from N. Line

Ft. from S. Line

330 Ft. from E. Line

Ft. from W. Line

APAN

Location

Rig up

Drilling and Remarks:

Did not drill deeper

T & A.

RECORD

Cased in., ft.

Sand

Gas

Oil

Total Depth 2960

PRODUCTION

1st 24 hrs. Nat.

1st 24 hrs. after shot

Gas Cu. Ft.

Dry Hole

Abandoned

Date

JUN 10 1936 19

S. J. LEWIS

Scout