


Section 21 Township 26 Range 5E

Well No. #86 Koogler

Company Magnolia

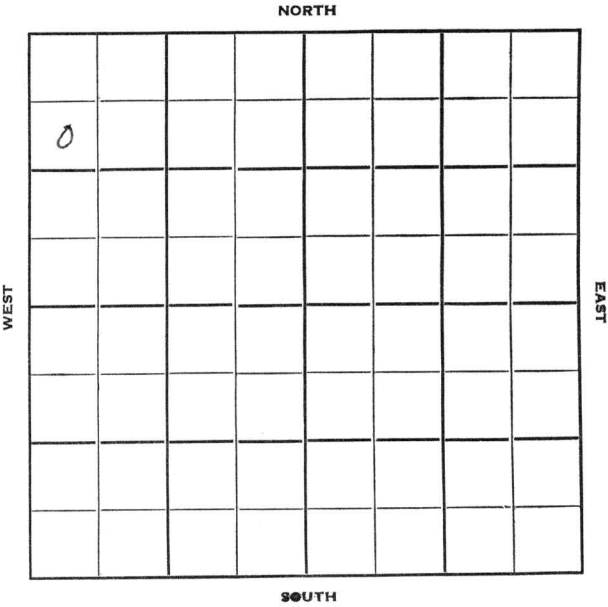

Butler

KANSAS

Sec. 21 Twp. 26 R. 5E

Well No. #86 Koogler Farm

Magnolia Company

Contractor


990' Ft. from N. Line

Ft. from S. Line

Ft. from E. Line

330' Ft. from W. Line

SW NW NW

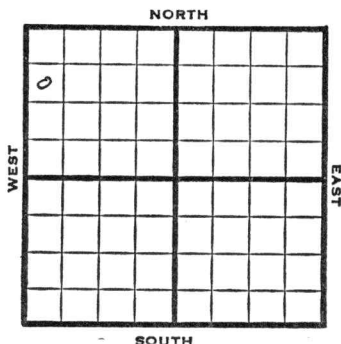

1950	Elv. - REPORT
11/22 1951	Location
1/3	Spud 11-26-50 Oil Well TD 2935 10" @ 108 Viola 2470-72 7" @ 2470 Simp 2497-98 500 A SSo TD 2526 B/8 goph DD 2935 PB 2529 Comp. 40 bopd

County Butler State KansasSec. 21 (Blk.) 26 (Sur.) 5E Map No.Operator MagnoliaWell No. 86 Farm KooglerElev. _____ Location SW NW NW

0									

990 Ft. From N Line NW330 Ft. From W Line Quarter1st. Report NOV 22 1950

Completion _____


Remarks _____

Spudding Date _____

Drig. Data _____

Location

J. E. TYRA

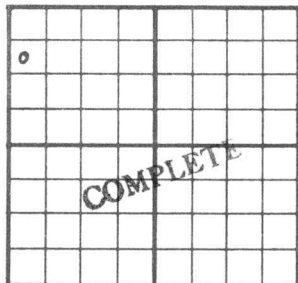County Butler State KansasSec. 21 (Blk.) 26 (Sur.) 5E Map No.Operator MagnoliaWell No. 86 Farm KooglerElev. Location SW NW NW990 Ft. From N Line NW330 Ft. From W Line Quarter

1st. Report

Completion JAN 3 1951

Remarks

Capitt Drlg. - Contr.Spudding Date 11-26-50Drlg. Data Oil well TD 293510" @ 108 Viola 2470-72 7" @ 2470Simp. 2497-98 500 A SSO TD 2526E/ 8 goph DD 2935 PB 2529Comp. 40 bopd

J. E. TYRA