FORM 51 25M 3-49 PETROL


KANSAS

Sedgwick

Section 32 Township 26 Range 2E

Well No. #1 Coleman

Company J. P. Gatty

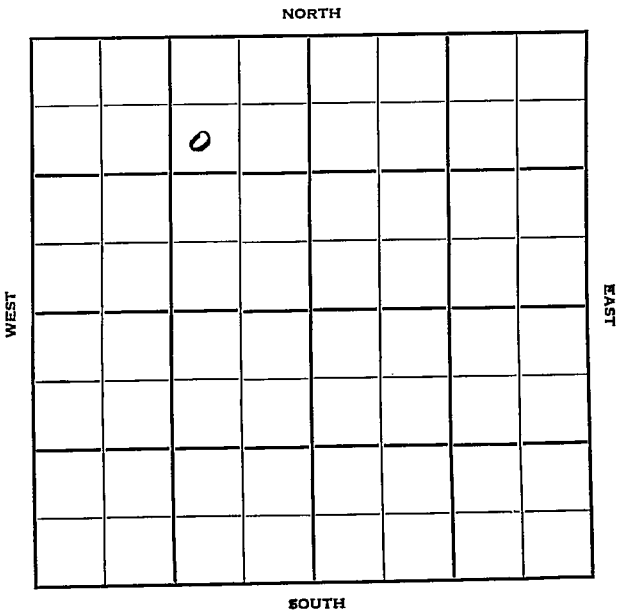

FORM-252-A
5M 10-48 PETROL

Sedgwick KANSAS

Sec. 32 Twp. 26 R. 2E

Well No. #1 Coleman Farm

J. P. Gatty Company

Miscellaneous


990' Ft. from N. Line

Ft. from S. Line

990' Ft. from E. Line

Ft. from W. Line

SW NE NW

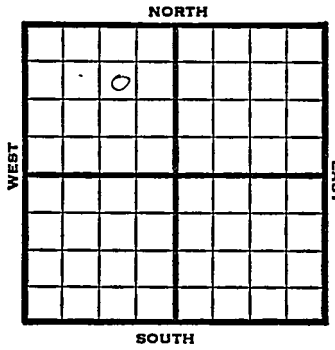


| 1950 | Elev 1407 | REPORT |
|---|---|---|
| 3/15 | RUR | |
| 5/17 | TD 3009<br>15½" @ 71<br>10" @ 1603<br>8" @ 2315<br>Lans 2160<br>Burgess sd 2959<br>Miss 3006<br>D&A | |

**ABANDONED**

Form 26 200 Bks. 11-49 Petrol Kansas Miscellaneous

Map No. _____ Sec. 32 Twp. 26 R. 2E

Well No. 1 Coleman

J. P. Gatty Company

_____ Contractor

SW NE NW

990 Ft. from N. Line


_____ Ft. from S. Line

990 Ft. from E. Line

_____ Ft. from W. Line

Sedgwick County

SECTION PLAT

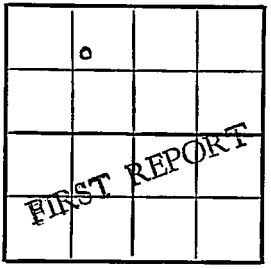


Location _____

Rig up _____

Drilling and Remarks:

R U R

RECORD

Cased _____ in., _____ ft.

Sand _____

Gas _____

Oil _____

Total Depth _____

PRODUCTION

1st 24 hrs. Nat. _____

1st 24 hrs. after shot _____

Gas _____ Cu. Ft.

Dry Hole _____

Abandoned _____

Date

MAR. 15 1950 19 J. E. TYRA Scout

Form 26 200 Bks. 11-49 Petrol Kansas Miscellaneous

Map No. _____ Sec. 32 Twp. 26 R. 2E

Well No. 1 Coleman


J. P. Gatty Company

- - - Contractor

SW NE NW

El. 1407

SECTION PLAT

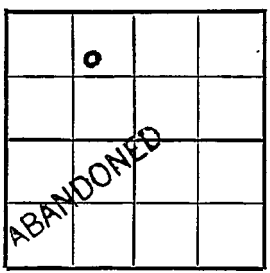


990 Ft. from N. Line

_____ Ft. from S. Line

990 Ft. from E. Line

_____ Ft. from W. Line

Sedgwick

Location _____

Rig up _____

Drilling and Remarks:

15½" @ 71

10" @ 1603

8" @ 2315

Lans 2160

Burgess Sd 2959

Miss 3006

D & A

RECORD

Cased _____ in., _____ ft.

Sand _____

Gas _____

Oil _____

Total Depth 3009

PRODUCTION

1st 24 hrs. Nat. _____

1st 24 hrs. after shot _____

Gas _____ Cu. Ft.

Dry Hole _____

Abandoned _____

Date

MAY 17 1959

J. E. TYRA Scout