

Section 23 Township 26 Range 3 EWell No. # 1 MathersCompany Rex & Morris

NORTH

WEST								EAST
	0							

SOUTH

Sec. **23** Twp. **26** R. **3E**

Well No. **#1 Mathers** Farm

Rex & Morris Company

Contractor

Wildcat


Ft. from N. Line

330 Ft. from S. Line

Ft. from E. Line

330 Ft. from W. Line

SW SW NW

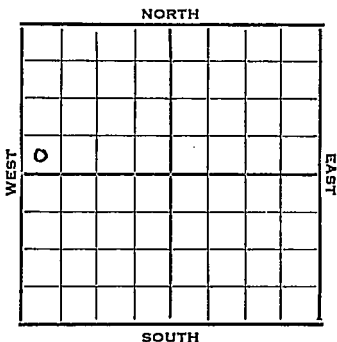

1925 Elev. **1364'** R E P O R T

8/27 Spud **8-24-52**

9/4 Spud **8-24-52**

D&A TD 2795

8" @ 125

KC 2354 BKC 2528


Miss 2775 Miss dol. 2788

TD 2795 D&A

ABANDONED

J. G. McGEHEE

County Butler State Kansas
 Sec. 23 (Blk. 26 (Sur. 3E Map No.
 (Twp.) (Rge.)
 Operator Rex & Morris
 Well No. 1 Farm Mathers
 Elev. 1364 Location SW SNNW

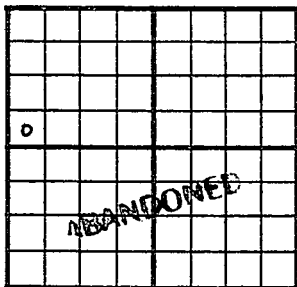

330 Ft. From S Line NW
330 Ft. From W Line Quarter
 Ist. Report
 Completion SEP 4 1952
 Remarks Wildcat

Spudding Date 8-24-52
 Drlg. Data D & A TD 2795
8" @ 125 KC 2354 B KC 2528
Miss. 2775 Miss. dpl. 2788 TD 2795
D & A

J. G. McGEHEE