

Well No. 1 - Harnane Farm

NORTH

WEST

EAST

SOUTH

Rig Up_____

Drilling Remarks

PRODUCTION

1st 24 hrs. Nat.-----

1st 24 hrs. after shot_____

Gas_____cu. ft.

Dry Hole

Abandoned


Kansas
 Map No. _____ Sec. 20 Twp. 26 R. 3E
 Well No. 1-Parane Farm _____
Barnsdall Oil Company

_____ Ft. from N. Line

330 Ft. from S. Line

_____ Ft. from E. Line

990 Ft. from W. Line

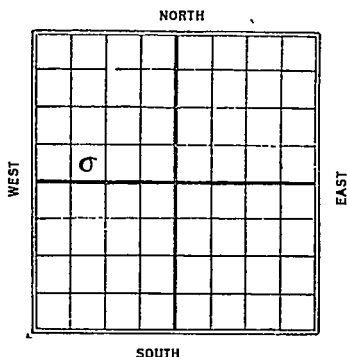

1927

Date _____ REPORT

2/23	Location
3/2	_____
3/9	_____
3/16	_____
3/23	_____
3/30	Rig
4/6	Rigging up
4/13	Drlg 860
4/20	" 1120
4/27	" 1460
5/4	" 1815
5/11	" 2275
5/18	T.D. 2275 - str. ream.
5/25	Drlg 2465.
6/1	S.D. 2465
6/8	_____
6/15	Top Chat 2863 - show oil 2865 running liner -
6/22	Chat 2854 - 58 (S.L.M.) 28 bbls oil 13 hrs - top line 2863 -
6/29	Top Chat 2854 T.D. 2863 Swab 36 bbls


Map No. 13 KANSAS Sec. 20 Twp. 26 R. 3E


Barnscliff Oil Company

Contractor

SECTION PLAT

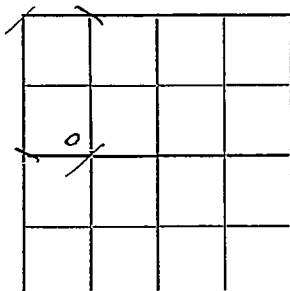

_____ Ft. from N. Line

330 Ft. from S. Line

_____ Ft. from E. Line

990 Ft. from W. Line

FIRST REPORTS

Location ✓

Rig up _____

Drilling and Remarks:

RECORD

Cased _____ in., _____ ft.

Sand _____

Gas _____

Oil _____

Total Depth _____

PRODUCTION

1st 24 hrs. Nat. _____

1st 24 hrs. after shot _____

Gas _____ Cu. Ft.

Dry Hole _____

Abandoned _____

Date

FEB 23 1927

S. J. LEWIS

Scout

Butler
13 KANSAS

Map No. _____ Sec. 20 Twp. 26 R. 3E

Well No. 1 Marnane

Barnsclall Oil Company

Contractor

SECTION PLAT


_____ Ft. from N. Line

330 Ft. from S. Line

_____ Ft. from E. Line

990 Ft. from W. Line

COMPLETED

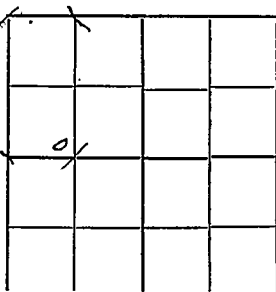

Location _____

Rig up _____

Drilling and Remarks:

Top Chas 2854

TII 2863

Swat 3688 1/2

RECORD

Cased _____ in., _____ ft.

Sand _____

Gas _____

Oil _____

Total Depth _____

PRODUCTION

1st 24 hrs. Nat. _____

1st 24 hrs. after shot _____

Gas _____ Cu. Ft.

Dry Hole _____

Abandoned _____

Date _____

JUN 29 1927

S. J. LEWIS Scout