


KANSAS

Greenwood

Section 6 Township 25 Range 13E

Well No. 4 Gilroy

Company Bisagna

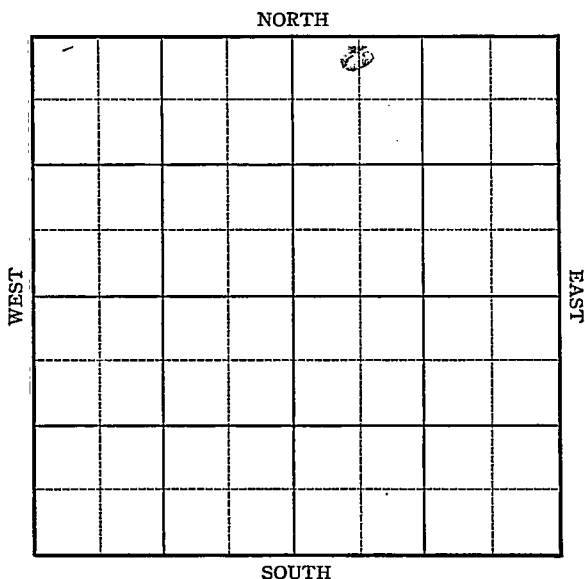

KANSAS

Greenwood

Sec. 6 Twp. 25 R. 13-E

Well No. #4 Gilroy Farm

Bisagna Company


Miscellaneous

330 Ft. from N. Line

 Ft. from S. Line

 Ft. from E. Line

660 Ft. from W. Line

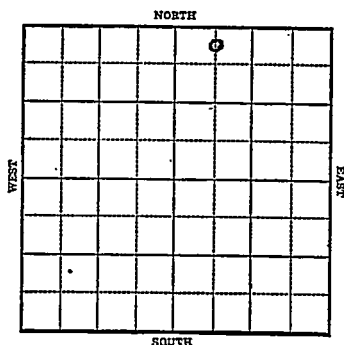

1942

R E P O R T

10/21

12" - 25' 8" - 1200'
Miss. 1639' 6" - 1639'
T. D. 1668' 40 qts. 1648'-56' C.O.

10/28

Miss. 1639
6" - 1639
40 qts. 1648-56
T.D. 1668'
Pump 24 Pot. plus 35 water
Gravity 35.


COMPLETED

Greenwood KANSAS

Map No. 17 Sec. 6 Twp. 25 ' R. 13EWell No. 4 GilroyBisagna CompanyFIRST REPORT Contractor

C NL NW NE

SECTION PLAT

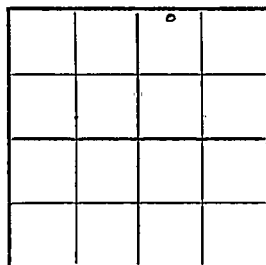330 Ft. from N. Line Ft. from S. Line Ft. from E. Line660 Ft. from W. Line

MISCELLANEOUS

Location Rig up

Drilling and Remarks:

12"-25'8"-1200'Miss. 1639'6"-1639'1668' T.D.40 qts. 1648' -56' C.O.

RECORD

Cased in., ft.Sand Gas Oil Total Depth

PRODUCTION

1st 24 hrs. Nat. 1st 24 hrs. after shot Gas Cu. Ft.Dry Hole Abandoned

Date

OCT 21 1942 19S. J. LEWIS Scout

Map No. 17 Sec. 6 Twp. 25 R. 13EWell No. 4 GilroyBisagna CompanyCOMPLETED Contractor

C N L NW NE

330 Ft. from N. Line Ft. from S. Line Ft. from E. Line660 Ft. from W. Line

MISCELLANEOUS

SECTION PLAT

		0	

Location Rig up

Drilling and Remarks:

*Miss 1639**6 "C 1639**409 to 1648-56**Pump 24028**+ 25 Water**25° Gr*

RECORD

Cased in., ft.Sand Gas Oil Total Depth 1668

PRODUCTION

1st 24 hrs. Nat. 1st 24 hrs. after shot Gas Cu. Ft.Dry Hole Abandoned

Date

OCT 28 1942 19S. J. LEWIS Scout