


Map No. _____ Sec. 7 Twp. 26 R. 5
 Well No. 17 Anderson Farm
Empire Company

NORTH

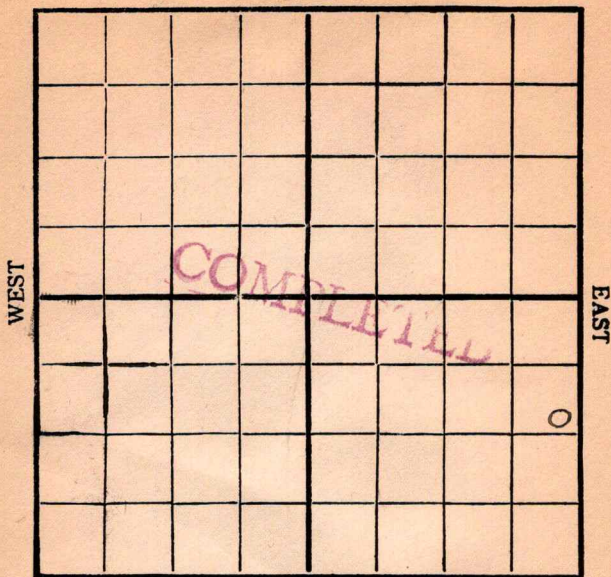

SOUTH

Location _____

Rig Up _____

Drilling Remarks:

Drilling Remarks:

8-23-19

Sand 2418-2469' 15 hrs
in 3 hours

RECORD

Cased _____ in. _____ ft.

Sand _____

Gas _____

Oil _____

Total Depth _____

PRODUCTION

1st 24 hrs. Nat. _____

1st 24 hrs. after shot _____

Gas _____ cu. ft.

Dry Hole _____


Abandoned _____

Map No. 1514 Sec. 7 Twp. 26 R. 5
 Well No. 17 Anderson
Empire _____ Compan _____
 _____ Contractor _____

NORTH

WEST

EAST

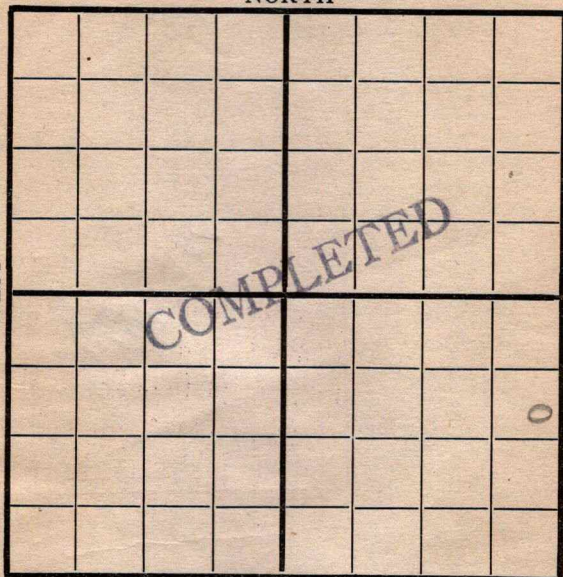

239 E

SOUTH

1025 N

Location _____

Rig up _____

Drilling and Remarks:

15 bbls
in 3 hrs

RECORD

Cased _____ in., _____ ft.

Sand 2418 - 2469

Gas _____

Oil _____

Total Depth _____

PRODUCTION

1st 24 hrs. Nat. _____

1st 24 hrs. after shot _____

Gas _____ Cu. Ft.

Dry Hole _____

Abandoned _____

Date

8/19

1919

Pyle Scout