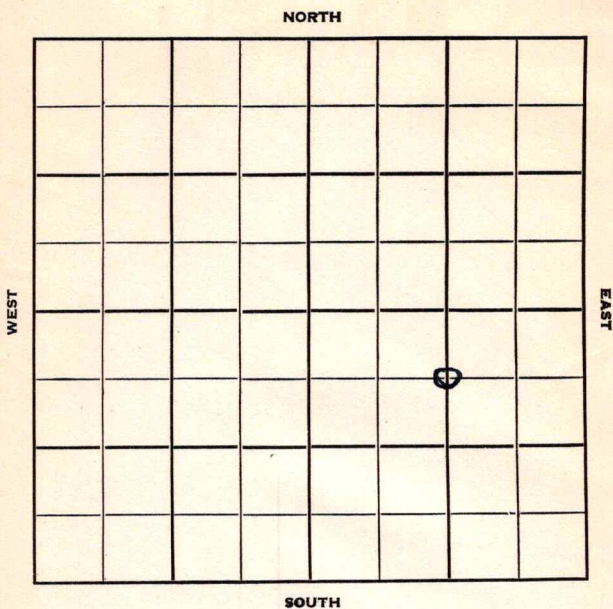


Section 7 Township 26 Range 5EWell No. #22 AndersonCompany Cities Service Oil

Sec. 7 Twp. 26 R. 5 E

Well No. # 22 Anderson

Farm _____

Cities Service Oil

Company _____

Contractor _____

660

Ft. from N. Line


Ft. from S. Line

1320

Ft. from E. Line

Ft. from W. Line

C N/2 SE

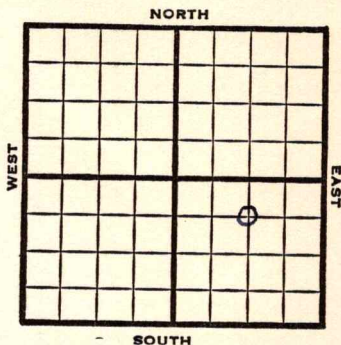

1952

Elev. 1367'

REPORT

1/9 Drlg. 355'

1/23 Oil Well TD 2453

8" @ 90 Lans. 1650 KC 1959

Arb. 2420 TD 2431 5" @ 2428

DD 2453 25 qt/ 2439-49

Comp. 34 BOPD 14 BW

COMPLETED

County **Butler** State **Kansas**
Sec. **7** (Blk.) **26** (Sur.) **5E** Map No.

Operator **Cities Service Oil**

Well No. **22** Farm **Anderson**

Elev. Location **C N/2 SE**

FIRST REPORT

8 3.8

660 Ft. From **N** Line **SE**

1320 Ft. From **E** Line Quarter

1st. Report **JAN 9 1952**

Completion

Remarks

Spudding Date

Drlg. Data

Drlg. 355


J. E. TYRA

County Butler State Kansas
 Sec. 7 (Blk. 26) (Sur. 5E) Map No.

Operator Cities Service Oil

Well No. 22 Farm Anderson

Elev. 1367 Location C N L SE/4

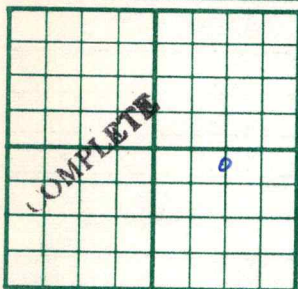

660 Ft. From N Line SE

1320 Ft. From E Line Quarter

1st. Report

Completion JAN 23 1952

Remarks

Spudding Date

Drig. Data Oil well TD 2453

8" @ 90 Lans. 1650 KC 1959

Arb. 2420 TD 2431 5" @ 2428

DD 2453 25 qt/ 2439-49

Comp. 34 bopd 14 bw

J. G. McGEHEE