


Section 6 Township 25 Range 13E

Well No. 1 - Stœckle

Company Ray Bergen

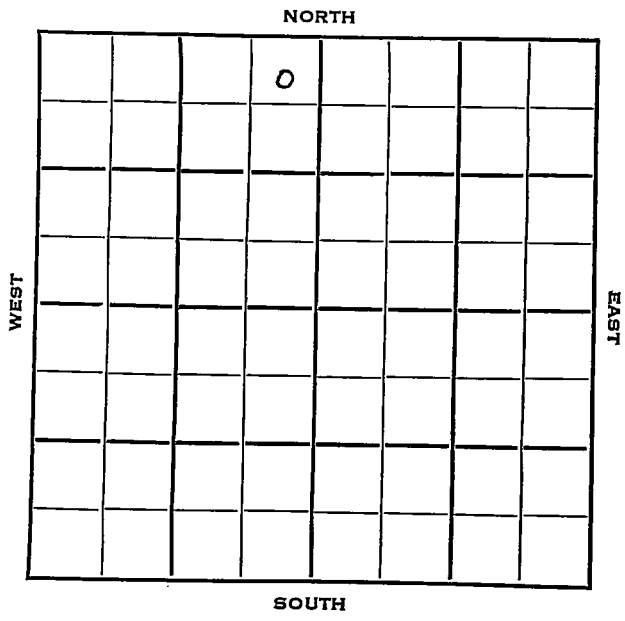

Greenwood **KANSAS** ✓

Sec. 6 Twp. 25 R. 13E

Well No. #1 Steckle Farm

Ray Bergen Company

Contractor


330 Ft. from N. Line

 Ft. from S. Line

330 Ft. from E. Line

 Ft. from W. Line

NE NE NW

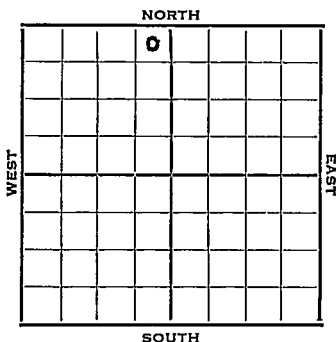


1952 Elev. - REPORT

12/23 TD 1640
S/4 boph
25 bopd

1953
1/7 OilWell
T_a 1681
Miss 1662
TD 1681
4" @ 1667
Comp. 40 BOPD 10% wtr.

COMPLETED

J. G. McGEHEE

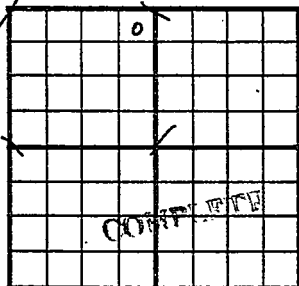County Greenwood State KansasSec. 6 (Blk. Twp.) 25 (Sur. Rge.) 13E Map No.Operator Ray BergenWell No. 1 Farm SteckleElev. Location NE NE NW330 Ft. From N Line NW330 Ft. From E Line Quarter1st. ReportCompletion JAN 7 1953RemarksSpudding DateDrlg. Data Oil well TD 1681Miss. 1662 TD 1681 4" @ 1667Comp. 40 bopd 10% wtr.

J. G. McGEHEE