

Section

7

Township

26

Range


5E

Well No.

#21 Anderson

Company

Cities Service Oil

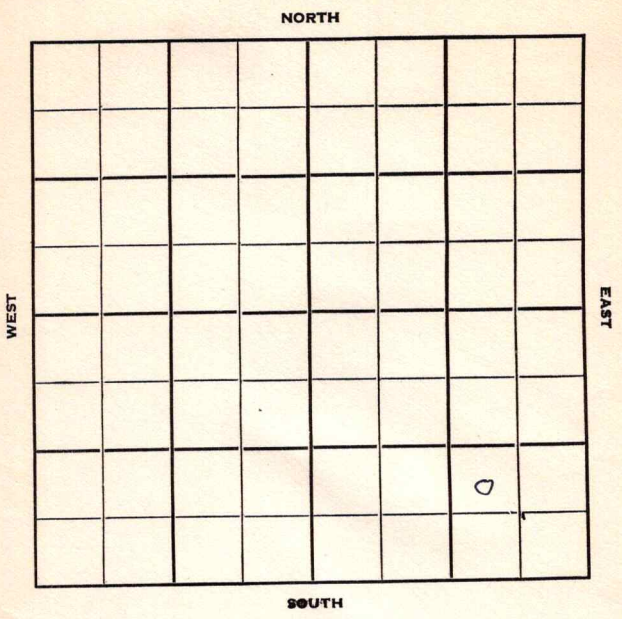

Butler

KANSAS

Sec. 7 Twp. 26 R. 5E ✓Well No. #21 Anderson Farm _____

Cities Service Oil

Company _____


Contractor _____

Ft. from N. Line

990 Ft. from S. Line330 Ft. from E. Line

Ft. from W. Line

NW SE SE

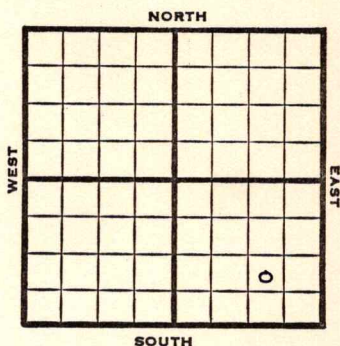1951 **Elev. 1361'** REPORT

12/5 Spud 11-18-51
8" @ 95
Lans. 1649 KC 1948
Arb. 2409
TD 2411'
5" @ 2410'

12/19 Spud 11-18-51
Oil well TD 2432' 8" @ 95
Lans. 1649' KC 1948' Arb. 2409'
5" @ 2410' TD 2432' 500 A
Comp. 36 BOPD

COMPLETED

County **Butler** State **Kansas**
 Sec. **7** (Blk.) **26** (Sur.) **5E** Map No.
 Operator **Cities Service Oil**
 Well No. **21** Farm **Anderson**
 Elev. Location **NW SE SE**



990 Ft. From **S** Line **SE**
330 Ft. From **E** Line Quarter

1st. Report **DEC 5 1951**

Completion

Remarks

Spudding Date **11-18-51**

Drlg. Data

8" @ 95 **Lans. 1649** **KC 1948** **Arb. 2409**
TD 2411 **5" @ 2410**

J. E. TYRA

County Butler State Kansas
 Sec. 7 (Blk. 26 (Sur. 5E Map No.

Operator Cities Service Oil

Well No. 21 Farm Anderson

Elev. 1361 Location NW SE SE



990 Ft. From S Line SE

330 Ft. From E Line Quarter

1st. Report

Completion DEC 1 9 1951

Remarks

Spudding Date 11-18-51

Drlg. Data Oil well TD 2432

8" @ 95 Lens. 1649 KC 1948

Arb. 2409 5" @ 2410 TD 2432 500 A

Comp. 36 bopd

J. E. TYRA