


Map No. _____ Sec 7 Twp. 26 R. 5Well No. John Apperman FarmSouth West Pet Co Company

NORTH

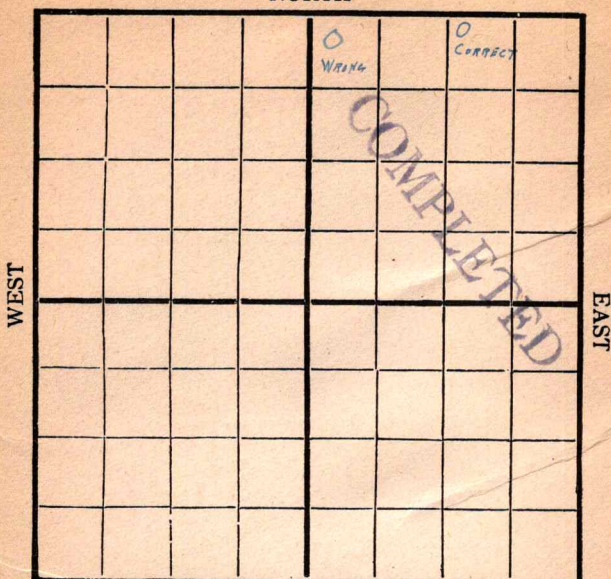

SOUTH

Location _____

Rig Up _____

Drilling Remarks:

Drilling Remarks:

RECORD

Cased _____ in _____ Ft.

Sand 2493-2515

Gas _____

Oil _____

Total Depth _____

PRODUCTION

1st 24 hrs. Nat. 500

1st 24 hrs. after shot _____

Gas _____ Cu. Ft.

Dry Hole _____

Abandoned _____

Map No. _____ Sec. 7 Twp. 26 R. 5Well No. John Opperman FarmSmith-Wilson Pet Company

NORTH

WEST

EAST

SOUTH

Location _____

Rig Up _____

Drilling and remarks

Location repeated

RECORD

Cased _____ in. _____ Ft.

Sand _____

Gas _____

Oil _____

Total Depth _____

PRODUCTION

1st 24 hrs. Nat. _____

1st 24 hrs. after shot _____

Gas _____ Cu. Ft.

Dry Hole _____


Abandoned _____

Date

July, 1916 McCord Scout

Map No. _____ Sec. 7 Twp. 26 R. 5
 Well No. 1 John Opperman Farm _____
South West Pet Co Company _____

NORTH

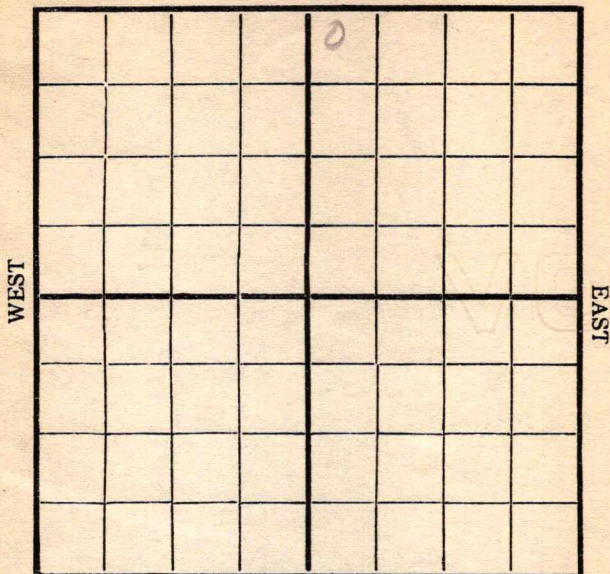

SOUTH

Location _____

Rig Up ☒

Drilling and remarks _____

RECORD

Cased _____ in. _____ Ft.

Sand _____

Gas _____

Oil _____

Total Depth _____

PRODUCTION

1st 24 hrs. Nat. _____

1st 24 hrs. after shot _____

Gas _____ Cu. Ft.

Dry Hole _____

Abandoned _____


Date

6/10, 1916 B. B. Bandy Scout

Map No. _____ Sec. 7 Twp. 26 R. 5Well No. 15 John P. Pofferman FarmScott Oil Co. Company

NORTH

WEST

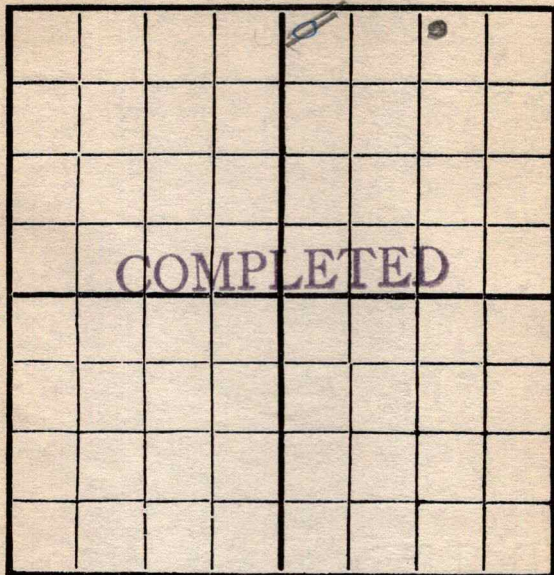

EAST

SOUTH

Location _____

Rig Up ✓

Drilling and remarks

Completed
August 3 and
Estimated 7500
bbls per day.
Note Change of Loc.

RECORD

Cased _____ in. _____ Ft.

Sand 2493 - 2515

Gas _____

Oil _____

Total Depth _____

PRODUCTION

1st 24 hrs. Nat. Est. 500 bbls

1st 24 hrs. after shot _____

Gas _____ Cu. Ft.

Dry Hole _____

Abandoned _____

Date

6/10, 1916 L. B. B. Scout

Map No. _____ Sec. 7 Twp. 26 R. 5Well No. 1 John Oppenheimer Farm
South Western Ref Company

NORTH

WEST

EAST

SOUTH

Location _____

Rig Up _____

Drilling and remarks
825

RECORD

Cased _____ in. _____ Ft.

Sand _____

Gas _____

Oil _____

Total Depth _____

PRODUCTION

1st 24 hrs. Nat. _____

1st 24 hrs. after shot _____

Gas _____ Cu. Ft.

Dry Hole _____

Abandoned _____


Date

6/19, 1916 Leander Scout

Map No. _____ Sec. 7 Twp. 26 R. 5
 Well No. 1 John D. Apperson Farm
South West P. Co. Company

NORTH

WEST

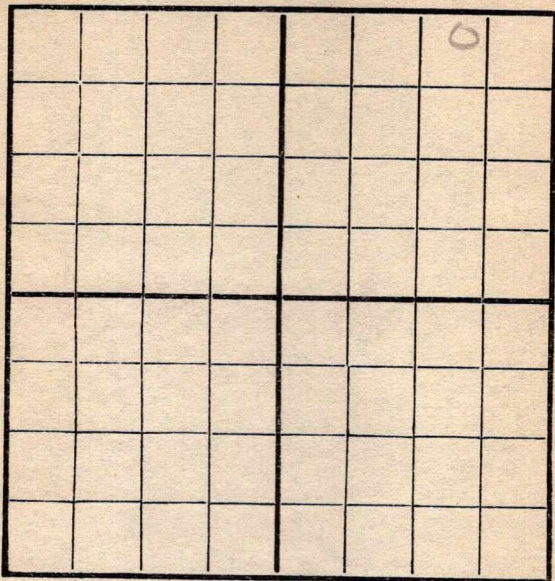

EAST

SOUTH

Location _____
 Rig Up _____
 Drilling and remarks

1350'

RECORD

Cased _____ in. _____ Ft.
 Sand _____
 Gas _____
 Oil _____
 Total Depth _____

PRODUCTION

1st 24 hrs. Nat. _____
 1st 24 hrs. after shot _____
 Gas _____ Cu. Ft.
 Dry Hole _____
 Abandoned _____

Date

6/24, 1916 John D. Apperson Scout


Map No. _____ Sec. 7 Twp. 26 R. 5

Well No. _____ Farm _____

Company _____

NORTH

WEST

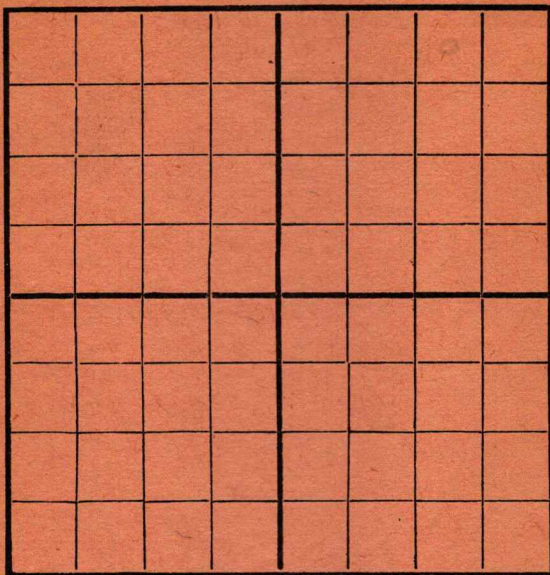

EAST

SOUTH

Location _____

Rig Up _____

Drilling and remarks _____

RECORD

Cased _____ in. _____ Ft.

Sand _____

Gas _____

Oil _____

Total Depth _____

PRODUCTION

1st 24 hrs. Nat. _____

1st 24 hrs. after shot _____

Gas _____ Cu. Ft.

Dry Hole _____

Abandoned _____

Date

7/6, 191


Scout

Map No. _____ Sec. 7 Twp. 26 R. 5Well No. 1 Oppenheimer Farm _____S-M-Ret Company _____

NORTH

WEST

EAST

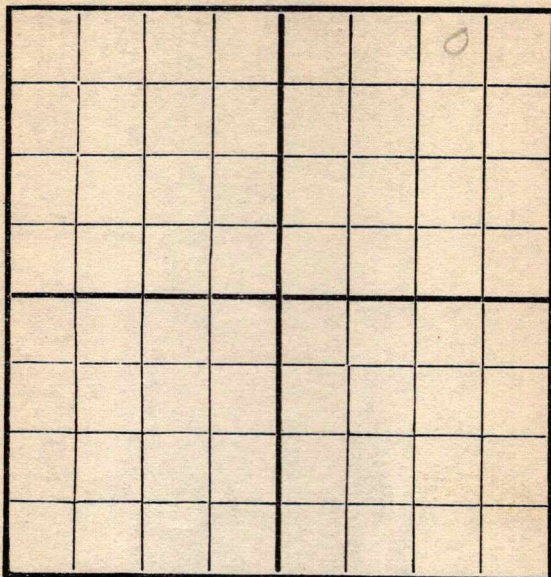

SOUTH

Location _____

Rig Up _____

Drilling and remarks

2240'

RECORD

Cased _____ in. _____ Ft.

Sand _____

Gas _____

Oil _____

Total Depth _____

PRODUCTION

1st 24 hrs. Nat. _____

1st 24 hrs. after shot _____

Gas _____ Cu. Ft.

Dry Hole _____

Abandoned _____


Date

7/13, 1916 Scout Scout

Map No. _____ Sec. 7 Twp. 26 R. 5
 Well No. 170 Opferman Farm
Do. West. Plot Co Company

NORTH

WEST

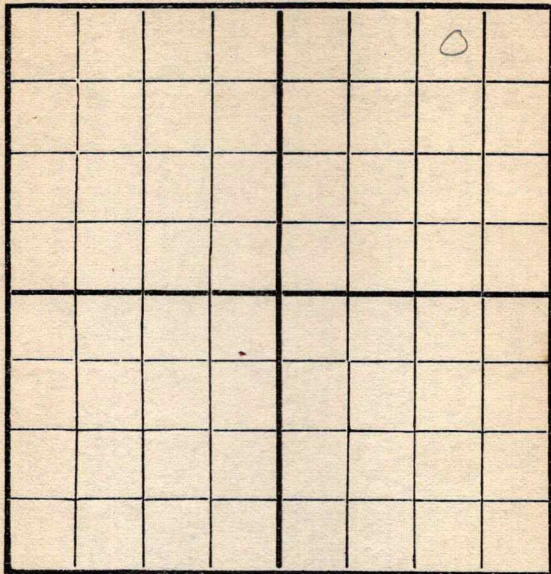

EAST

SOUTH

Location _____
 Rig Up _____

Drilling and remarks

2490' Hole
full salt
water

RECORD

Cased _____ in. _____ Ft.
 Sand _____
 Gas _____
 Oil _____
 Total Depth _____

PRODUCTION


1st 24 hrs. Nat. _____
 1st 24 hrs. after shot _____
 Gas _____ Cu. Ft.
 Dry Hole _____
 Abandoned _____

Date

7/7, 1916 Do. West. Plot Co Scout

Map No. _____ Sec. 7 Twp. 26 R. 5
 Well No. 10 Farm _____
S-W 1/4 Company _____

NORTH

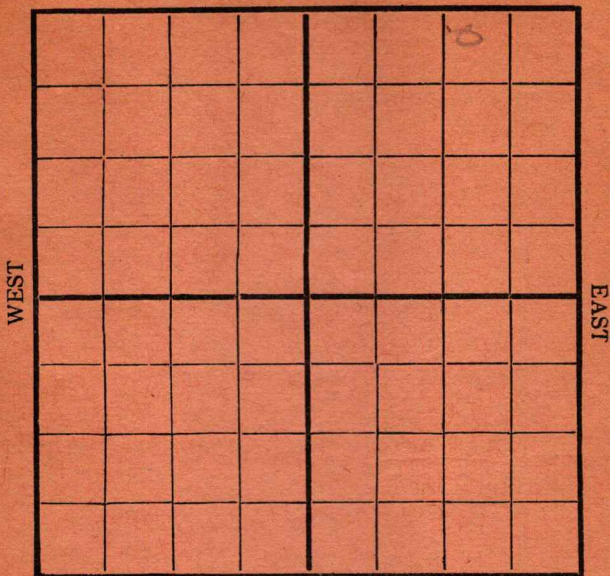

SOUTH

Location _____
 Rig Up _____
 Drilling and remarks _____

RECORD

Cased _____ in. _____ Ft.
 Sand _____
 Gas _____
 Oil _____
 Total Depth _____

PRODUCTION

1st 24 hrs. Nat. _____
 1st 24 hrs. after shot _____
 Gas _____ Cu. Ft.
 Dry Hole _____
 Abandoned _____

Date

7/29, 1916 Blair Scout


*Top sand
 2493'
 shut down
 waiting on
 order - 1000
 good showing*

Map No. _____ Sec. 7 Twp. 26 R 5Well No. 1 Oppheimer Farm _____S - M Pct Company _____

NORTH

WEST

EAST

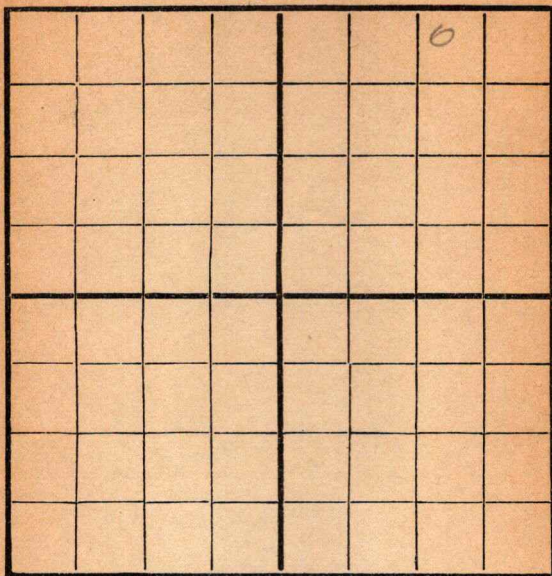

SOUTH

Location _____

Rig Up _____

Drilling and remarks

Hole full
oil. Could
not get estimate
as to what it
was good for
Building for

RECORD

Cased _____ in. _____ Ft.

Sand 2493-2510

Gas _____

Oil _____

Total Depth _____

PRODUCTION

1st 24 hrs. Nat. _____

1st 24 hrs. after shot _____

Gas _____ Cu. Ft.

Dry Hole _____

Abandoned yes

Date

8/3, 1916 L. C. ... Scout

Map No. _____ Sec. 7 Twp. 26 R. 5
 Well No. 107 Farm _____
W. J. Put Company _____

NORTH

WEST

EAST

SOUTH

Location _____

Rig Up _____

Drilling and remarks

Estimated
to be good
for 500 bbls

RECORD

Cased _____ in. _____ Ft.

Sand 2493-2515

Gas _____

Oil _____

Total Depth _____

PRODUCTION

1st 24 hrs. Nat. _____

1st 24 hrs. after shot _____

Gas _____ Cu. Ft.

Dry Hole _____

Abandoned _____

Date

8/9, 191 6 Blaney Scout