


KANSAS

Butler

Section 8 Township 26 Range 5-E

Well No. #2 Helberg

Company Smitherman

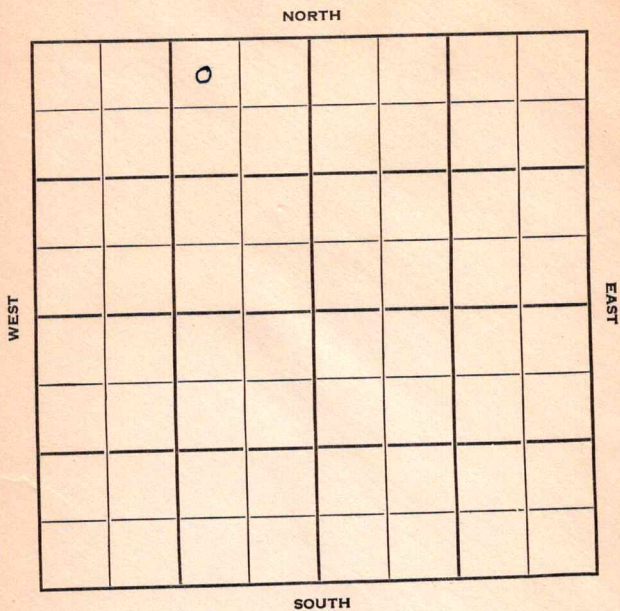

Sec. 8 Twp. 26 R. 5E 

Well No. #2 Helberg Farm
Smitherman Company

Contractor Miscellaneous


330' Ft. from N. Line

 Ft. from S. Line

990' Ft. from E. Line

 Ft. from W. Line

NW NE NW

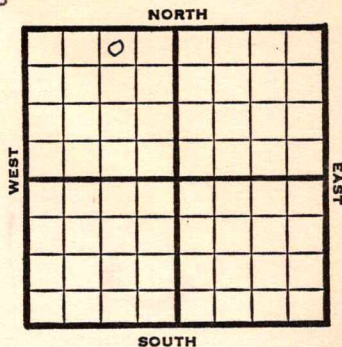

1950 **Elev. 1372'** REPORT

6/21 **Arb. 2429-30**
5" @ 2430'

6/28 **Arb 2429-30**
5" @ 2430

Lans 1686

KC 1972

Pay 2442-60 in Arb

50 qt 2442-60

Comp 60 bopd

Completed TD 2460

COMPLETED

Map No. _____ Sec. 8 Twp. 26 R. 5EWell No. 2 Helberg_____Smitherman_____
Company_____
Contractor

NW NE NW

El. 1372
SECTION PLAT330 Ft. from N. Line_____
Ft. from S. Line990 Ft. from E. Line_____
Ft. from W. Line

Butler County

Location _____

Rig up _____

Drilling and Remarks:

Arb. 2429-30

5" @ 2430

RECORD

Cased _____ in., _____ ft.

Sand _____

Gas _____

Oil _____

Total Depth _____

PRODUCTION

1st 24 hrs. Nat. _____

1st 24 hrs. after shot _____

Gas _____ Cu. Ft.

Dry Hole _____

Abandoned _____

Date

JUN 21 1950 19

J. E. TYRA Scout


Kansas

Map No. _____ Sec. 8 Twp. 26 R. 5EWell No. 2 Helberg_____Smitherman_____
Company_____
Contractor

NW NE NW

El. 1372

SECTION PLAT

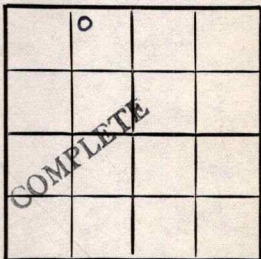330 Ft. from N. Line_____
Ft. from S. Line990 Ft. from E. Line_____
Ft. from W. Line

Butler County

Location _____

Rig up _____

Drilling and Remarks:

Arb. 2429-30

5" @ 2430

Lans. 16866

KC 1972

Pay 2442-60 in Arb

50 qt. 2442-60

Comp. 60 bopd

RECORD

Cased _____ in., _____ ft.

Sand _____

Gas _____

Oil _____

Total Depth 2460

PRODUCTION

1st 24 hrs. Nat. _____

1st 24 hrs. after shot _____

Gas _____ Cu. Ft.

Dry Hole _____

Abandoned _____

Date

JUN 28 1950

19

J. E. TYRA Scout