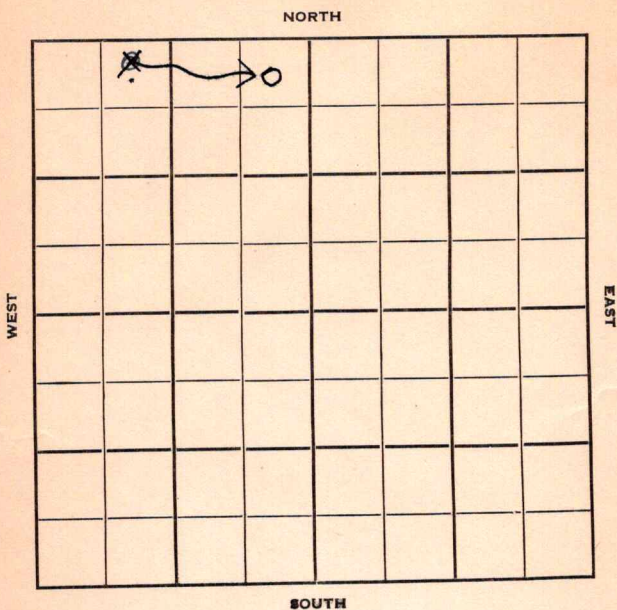


Section 8 Township 26 Range 5-E

Well No. #1 Anderson

Company L^C Smitherman



8

26

5E

Sec. _____ Twp. _____ R. _____

Well No. #1 Anderson Farm _____

L. C. Smitherman Company _____

Contractor _____

Miscellaneous

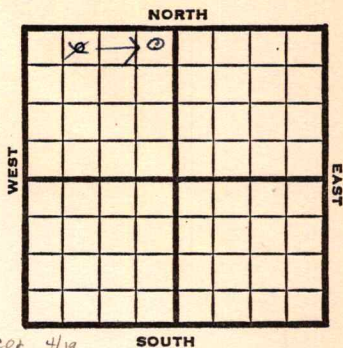
275' Ft. from N. Line

_____ Ft. from S. Line

330 Ft. from E. Line~~990'~~ Ft. from W. Line~~NE NW NW~~

NE NE NW

E-Cor 4/19

1950 **Elev 1371'** REPORT

4/5 8-5/8" @ 64'

4/19 TD 2455'
 8 5/8" @ 64
Arb. 2423'
 5 1/2" @ 2424'
 40/2435-55
 Comp 40 bopd
 Comp

COMPLETED

Map No. _____ Sec. 8 Twp. 26 R. 5EWell No. 1 Anderson_____
L. C. Smitherman Company_____
Contractor

NE NW NW

SECTION PLAT

275 Ft. from N. Line_____
Ft. from S. Line_____
Ft. from E. Line980 Ft. from W. Line

0			

FIRST REPORT

Butler County

Location _____

Rig up _____

Drilling and Remarks:

8 5/8" @ 64

RECORD

Cased _____ in., _____ ft.

Sand _____

Gas _____

Oil _____

Total Depth _____

PRODUCTION

1st 24 hrs. Nat. _____

1st 24 hrs. after shot _____

Gas _____ Cu. Ft.

Dry Hole _____

Abandoned _____

Date

APR 5 1950

19

J. E. TYRA

Scout

Map No. _____ Sec. 8 Twp. 26 R. 5EWell No. 1 AndersonL. C. Smitherman Company**CORRECTION** Contractor

NE NE NW

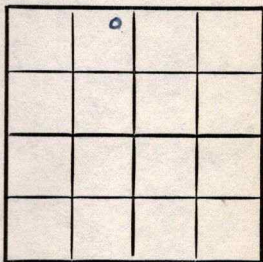
SECTION PLAT

275 Ft. from N. Line

_____ Ft. from S. Line

330 Ft. from E. Line

_____ Ft. from W. Line

Butler County

Location _____

Rig up _____

Drilling and Remarks:

Reported

NE NW NW

RECORD

Cased _____ in., _____ ft.

Sand _____

Gas _____

Oil _____

Total Depth _____

PRODUCTION

1st 24 hrs. Nat. _____

1st 24 hrs. after shot _____

Gas _____ Cu. Ft.

Dry Hole _____

Abandoned _____

Date

APR 19 1950 19J. E. TYRA Scout

Kansas

Miscellaneous

Map No. _____ Sec. 8 Twp. 26 R. 5EWell No. 1 AndersonL. C. Smitherman Company

Contractor

NE NE NW

E1.1371

SECTION PLAT

275 Ft. from N. Line

Ft. from S. Line

330 Ft. from E. Line

Ft. from W. Line

Butler County



Location _____

Rig up _____

Drilling and Remarks:

8 5/8" c 64

Arb. 2423

5 1/2" c 2424

40/ 2435-55

Comp. 40 bpsd

RECORD

Cased _____ in., _____ ft.

Sand _____

Gas _____

Oil _____

Total Depth 2455

PRODUCTION

1st 24 hrs. Nat. _____

1st 24 hrs. after shot _____

Gas _____ Cu. Ft.

Dry Hole _____

Abandoned _____

Date

APR 19 1950 19

J. E. TYRA

Scout