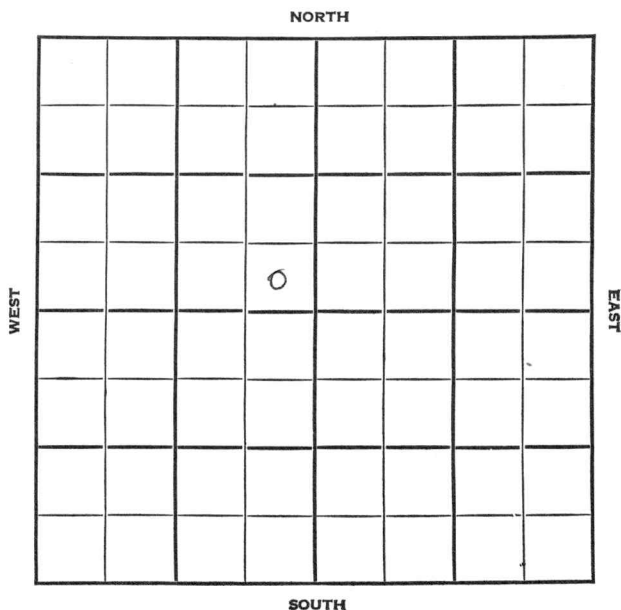


KANSAS

Butler

Section 19 Township 23 Range 4EWell No. 2 SchrivnerCompany H. V. Elwell


KANSAS

Sec. 19 Twp. 23 R. 4EWell No. #2 Schrivner FarmH. V. Elwell Company

Misc.

 Ft. from N. Line330 Ft. from S. Line330 Ft. from E. Line Ft. from W. Line

SE NW

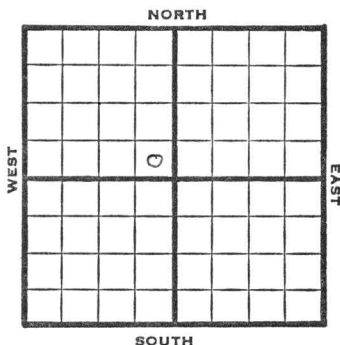

1948 Elev 1430' REPORT

4/28 Drlg. 250'

5/5 13" @ 1050'
Drlg. 1355'

5/12 KC 2100'
Drlg. 2115'

5/19 Mississippi 2374'
TD 2375'
7" @ 2374'
RUST

5/26 Hunton 2513'
TD 2555'
5" @ 2552'

6/1 PB 2223' 21 shots 2124-48'
2000 acid w/squeeze.

6/9 "

6/16 TD 2593'
KC 2049'
Hunton 2555'
5"@ 2552'
Perf KC
Pump 20 Oil / 200 W Pot
38⁶ Gr.
Comp.

COMPLETED

Map No. _____ Sec. 19 Twp. 23 R. 4E

Well No. 2 Schrivner

H. V. Elwell Company

FIRST REPORT Contractor

SE NW

SECTION PLAT

_____ Ft. from N. Line

330 Ft. from S. Line

330 Ft. from E. Line

_____ Ft. from W. Line

Butler County

Location _____

Rig up _____

Drilling and Remarks:

drlg. 250

RECORD

Cased _____ in., _____ ft.

Sand _____

Gas _____

Oil _____

Total Depth _____

PRODUCTION

1st 24 hrs. Nat. _____

1st 24 hrs. after shot _____

Gas _____ Cu. Ft.

Dry Hole _____

Abandoned _____

Date

APR 28 1948 19

S. J. LEWIS Scout

Map No. 14 Sec. 19 Twp. 23 R. 4E

Well No. 2 Schrivner

H. V. Elwell Company

COMPLETE

Contractor

SE NW

E11430

SECTION PLAT

 Ft. from N. Line

330 Ft. from S. Line

330 Ft. from E. Line

 Ft. from W. Line

Butler County

Location

Rig up

Drilling and Remarks:

HC.2049

Run to 2005

5" @ 2002

Box HC

Prod 20 oil + 200W

25 35-42

RECORD

Cased in., ft.

Sand

Gas

Oil

Total Depth 2083

PRODUCTION

1st 24 hrs. Nat.

1st 24 hrs. after shot

Gas Cu. Ft.

Dry Hole

Abandoned

Date

JUN 16 1948

19

S. J. LEWIS Scout