


Map No. _____ Sec. 8 Twp. 26 R. 5Well No. 6 Anderson Farm_____Empire_____
Company

NORTH

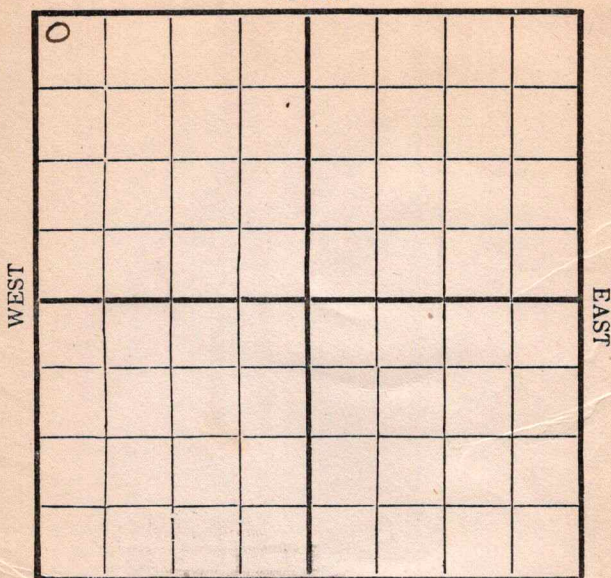

SOUTH

Location _____

Rig Up _____

Drilling Remarks:

Drilling Remarks:

RECORD

Cased _____ in _____ Ft.

S and _____

Gas _____

Oil _____

Total Depth _____

PRODUCTION

1st 24 hrs. Nat. _____

1st 24 hrs. after shot _____

Gas _____ Cu. Ft.


Dry Hole _____

Abandoned _____

Map No. _____ Sec. 8 Twp. 26 R. 5
Well No. 6 Anderson Farm _____
Empire Company _____

NORTH

WEST

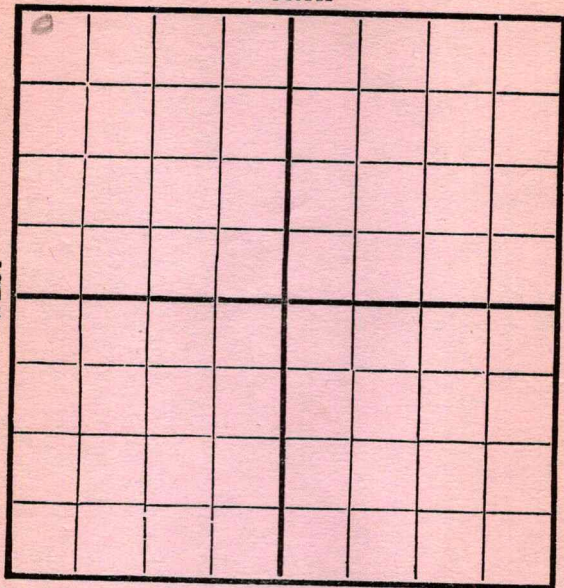

EAST

SOUTH

Location _____

Rig Up _____

Drilling and remarks _____

RECORD

Cased _____ in. _____ Ft.

Sand _____

Gas _____

Oil _____

Total Depth _____

PRODUCTION

1st 24 hrs. Nat. _____

First 24 hrs. after shot _____

Gas _____ Cu. Ft.

Dry Hole _____

Abandoned _____


FIRST REPORT

Date

2/5, 1917 Conroy Scout

Map No. _____ Sec. 8 Twp. 26 R. 5
 Well No. 6 Anderson Farm _____
Carpine Company _____

NORTH

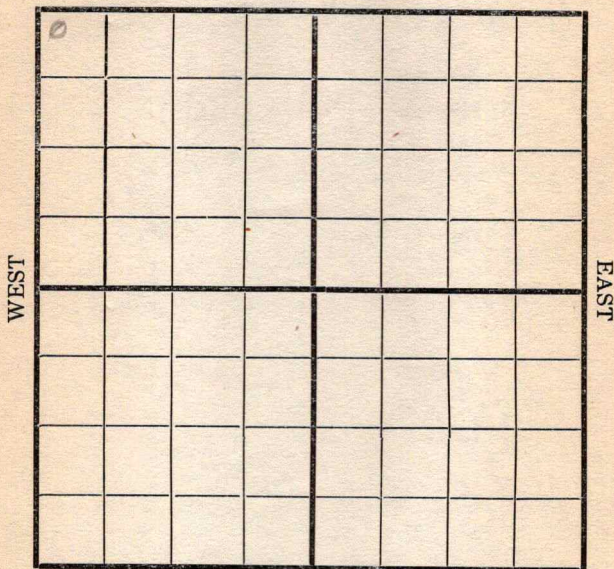

SOUTH

Location _____
 Rig Up ☒ _____
 Drilling and remarks _____

RECORD

Cased _____ in. _____ Ft.
 Sand _____
 Gas _____
 Oil _____
 Total Depth _____

PRODUCTION

1st 24 hrs. Nat. _____
 1st 24 hrs. after shot _____
 Gas _____ Cu. Ft.
 Dry Hole _____
 Abandoned _____

Date

2/12, 1917 Carlip Scout

Map No. _____ Sec. 8 Twp. 26 R. 5
 Well No. 6 Anderson Farm
Empire Company

NORTH

WEST

EAST

SOUTH

Location _____
 Rig Up ☒ _____
 Drilling and remarks _____

RECORD

Cased _____ in. _____ Ft.
 Sand _____
 Gas _____
 Oil _____
 Total Depth _____

PRODUCTION


1st 24 hrs. Nat. _____
 1st 24 hrs. after shot _____
 Gas _____ Cu. Ft.
 Dry Hole _____
 Abandoned _____

Date 2/19, 1917 C. Anderson Scout

Map No. _____ Sec. 8 Twp. 26 R. 5
 Well No. 6 Anderson Farm _____
Anderson Company _____

NORTH

WEST

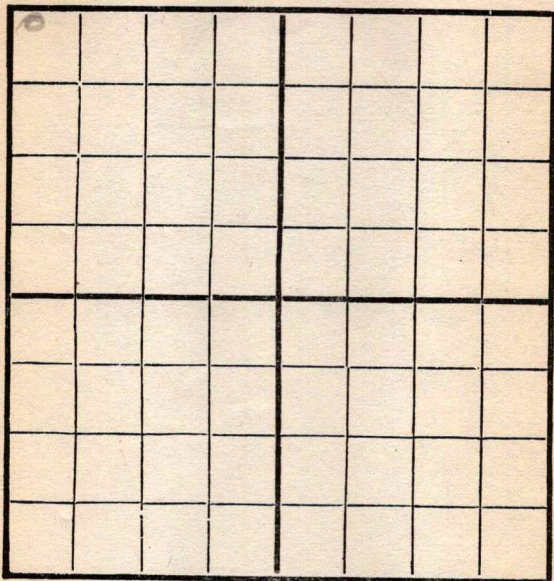

EAST

SOUTH

Location _____
 Rig Up ☒ _____
 Drilling and remarks _____

RECORD

Cased _____ in. _____ Ft.
 Sand _____
 Gas _____
 Oil _____
 Total Depth _____

PRODUCTION

1st 24 hrs. Nat. _____
 First 24 hrs. after shot _____
 Gas _____ Cu. Ft.
 Dry Hole _____
 Abandoned _____

Date

Feb 2, 1917 Anderson Scout

Map No. _____ Sec. 8 Twp. 26 R. 5
 Well No. 6 Anderson Farm _____
Engine Company _____

NORTH

WEST

EAST

SOUTH

Location ✓
 Rig Up _____
 Drilling and remarks _____

RECORD

Cased _____ in. _____ Ft.
 Sand _____
 Gas _____
 Oil _____
 Total Depth _____

PRODUCTION


1st 24 hrs. Nat. _____
 1st 24 hrs. after shot _____
 Gas _____ Cu. Ft.
 Dry Hole _____
 Abandoned _____

Date

3/5, 1917 Anderson Scout

Map No. _____ Sec. 8 Twp. 26 R. 5Well No. 6 Anderson FarmEmpire Company

NORTH

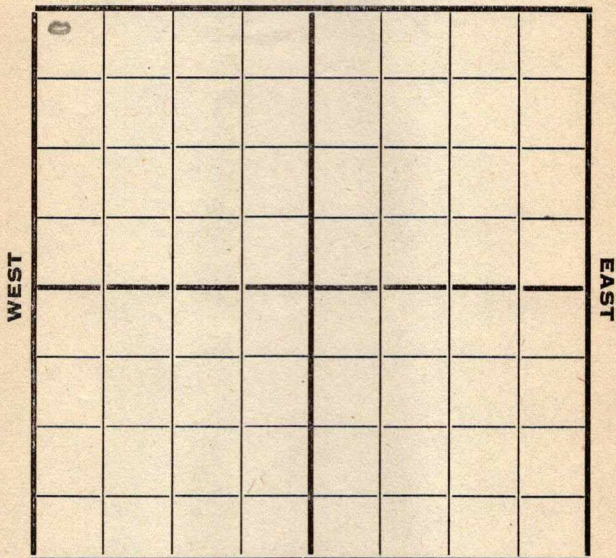

SOUTH

Location _____

Rig up _____

Drilling and Remarks:

RECORD

Cased _____ in. _____ Ft.

Sand _____

Gas _____

Oil _____

Total Depth _____

PRODUCTION

1st 24 hrs. Nat. _____

1st 24 hrs. after shot _____

Gas _____ Cu. Ft.

Dry Hole _____


Abandoned _____

Date

3/12, 1917

Scout

Map No. _____ Sec. 8 Twp. 26 R. 5
Well No. 6 Anderson Farm
Cumprine Company
NORTH

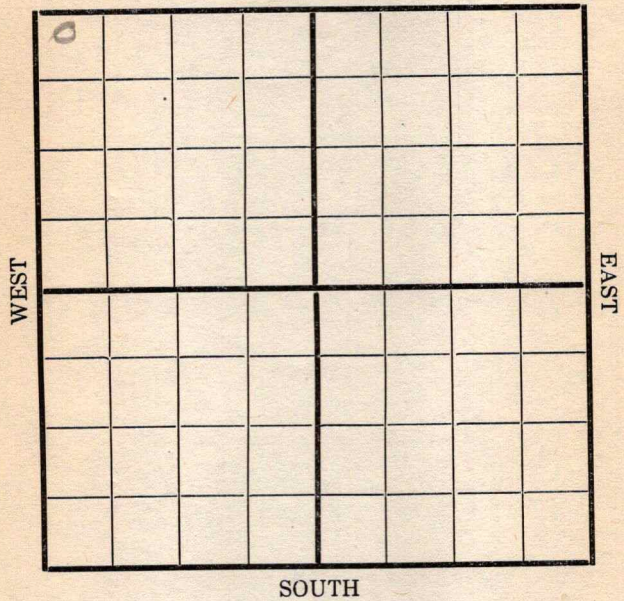

SOUTH

Location _____
Rig Up _____
Drilling and remarks
600

RECORD

Cased _____ in. _____ Ft.
Sand _____
Gas _____
Oil _____
Total Depth _____


PRODUCTION

1st 24 hrs. Nat. _____
1st 24 hrs. after shot _____
Gas _____ Cu. Ft.
Dry Hole _____
Abandoned _____

Date 3/21, 1912 Cumprine Scout

Map No. _____ Sec. 8 Twp. 26 R. 5Well No. 6 Anderson FarmEngine Company

NORTH

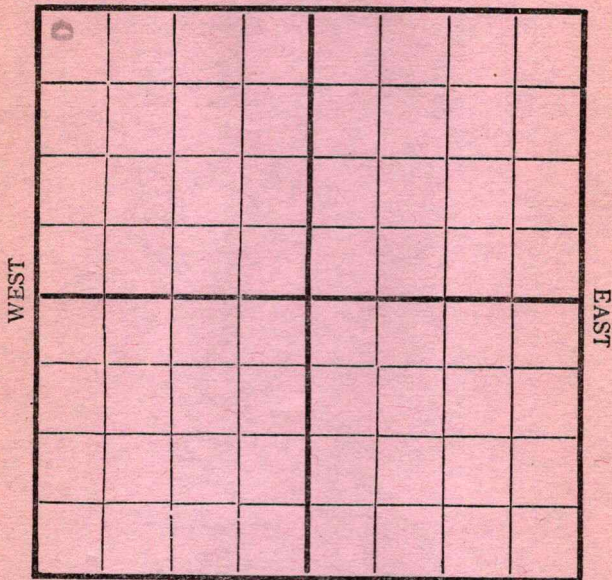

SOUTH

REMARKS:


1375

Date

9/26, 1912 Carley Scout

Map No. _____ Sec. 8 Twp. 26 R. 35
Well No. 6 Anderson Farm
Empire Company

NORTH

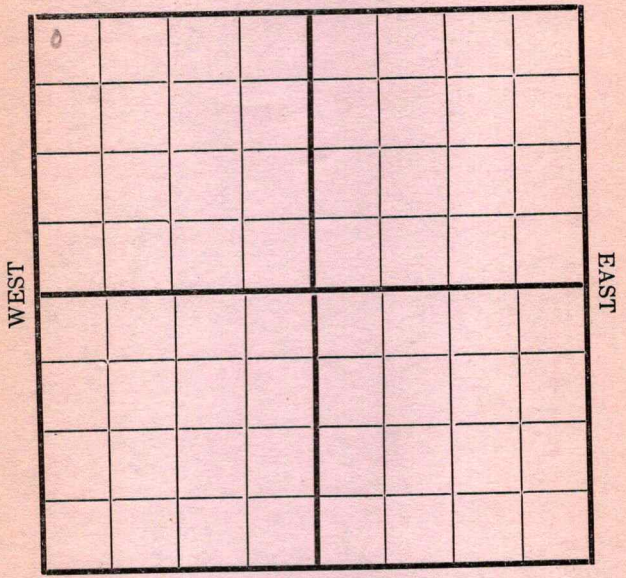

SOUTH

Location _____
Rig Up _____
Drilling and remarks

1820'

RECORD

Cased _____ in. _____ Ft.
Sand _____
Gas _____
Oil _____
Total Depth _____


PRODUCTION

1st 24 hrs. Nat. _____
1st 24 hrs. after shot _____
Gas _____ Cu. Ft.
Dry Hole _____
Abandoned _____

Date

4/5, 1917 Carley Scout

Map No. _____ Sec. 8 Twp. 26 R. 5
 Well No. 6 Anderson Farm _____
Cummins Company _____
 NORTH

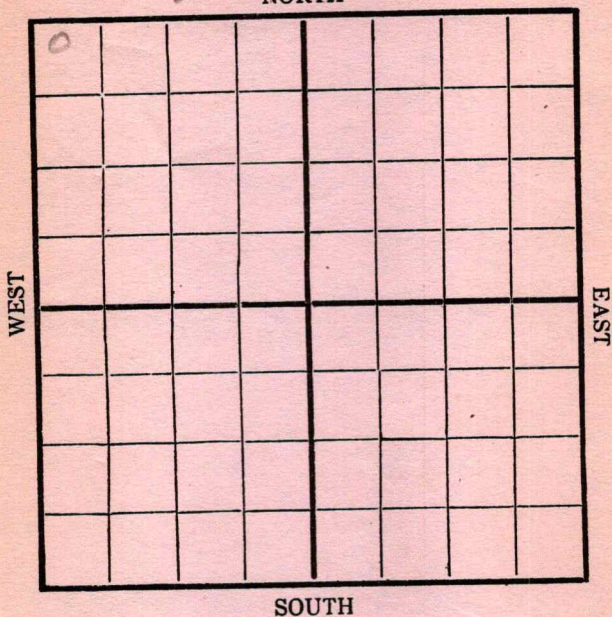

Location _____
 Rig Up _____
 Drilling and remarks

RECORD
 Cased _____ in. _____ Ft.
 Sand _____
 Gas _____
 Oil _____
 Total Depth _____

PRODUCTION
 1st 24 hrs. Nat. _____
 1st 24 hrs. after shot _____
 Gas _____ Cu. Ft.
 Dry Hole _____
 Abandoned _____

Date 4/11 1917 Cummins Scout _____

Map No. _____ Sec. 8 Twp. 26 R. 5
 Well No. 6 _____ Farm _____
 _____ Company _____

NORTH

0							

WEST

EAST

SOUTH

Location _____
 Rig Up _____
 Drilling and remarks _____

2415

RECORD

Cased _____ in. _____ Ft.
 Sand _____
 Gas _____
 Oil _____
 Total Depth _____

PRODUCTION


1st 24 hrs. Nat. _____
 1st 24 hrs. after shot _____
 Gas _____ Cu. Ft.
 Dry Hole _____
 Abandoned _____

Date 4/19, 1917 _____ Scout _____

4/26, 1917. *Carly* Scout

Map No. _____ Sec. 8 Twp. 26 R. 5Well No. 6 Anderson Farm __________Emp_____
Company

NORTH

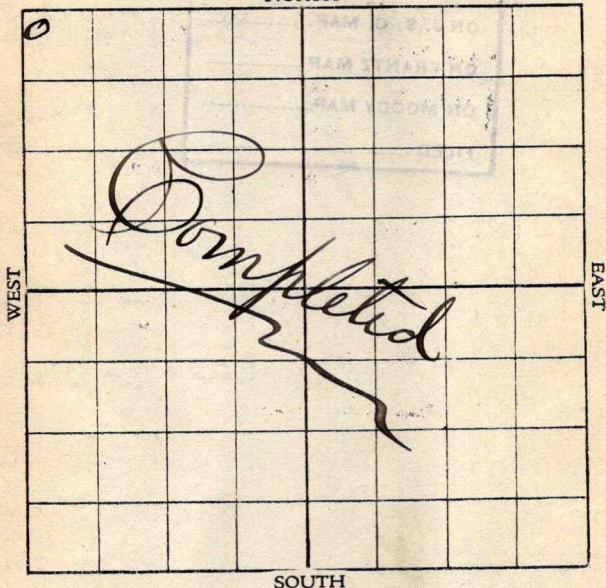

SOUTH

Location _____

Rig up _____

Drilling and remarks:

RECORD

Cased _____ in. _____ Ft.

Sand _____

Gas _____

Oil 2457-2471Total Depth 2471

PRODUCTION

1st 24 hrs. Nat. _____

1st 24 hrs. after shot _____

Gas _____ Cu. Ft.

Dry Hole _____


Abandoned _____

Date

5/5, 1917, Crocker Scout

Map No. _____ Sec. 8 Twp. 26 R. 5
 Well No. Anderson Farm _____
Engine Company _____

NORTH

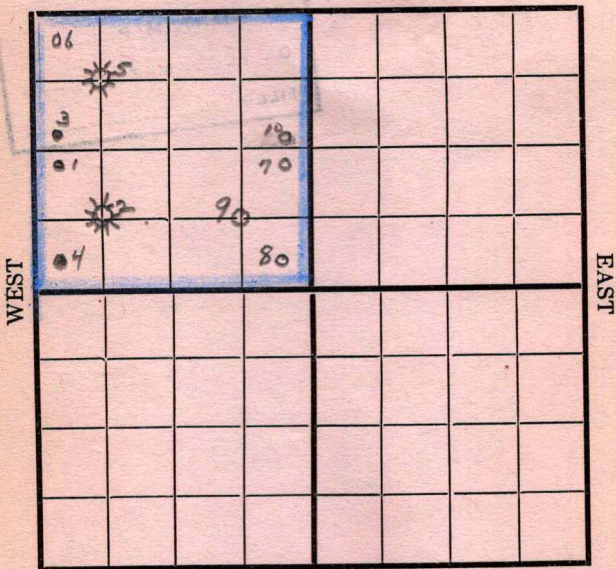

SOUTH

Location _____
 Rig Up _____
 Drilling and remarks _____

Platz
Anderson
from
nr of
8-26-5

RECORD

Cased _____ in. _____ Ft.
 Sand _____
 Gas _____
 Oil _____
 Total Depth _____

PRODUCTION

1st 24 hrs. Nat. _____
 1st 24 hrs. after shot _____
 Gas _____ Cu. Ft.
 Dry Hole _____
 Abandoned _____

Date

4/26 191 7

Scout