


Map No. _____ Sec. 28 Twp. 27 R. 4
 Well No. 16 Kramer Farm _____
Magnolia Company _____
 NORTH

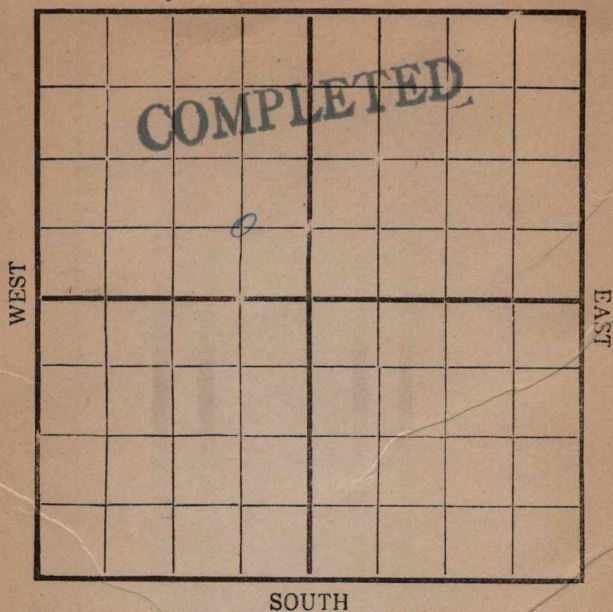

Location _____

Rig Up _____

Drilling Remarks:

Drilling Remarks:

RECORD

Cased _____ in _____ Ft.
 Sand _____
 Gas _____
 Oil _____
 Total Depth _____


PRODUCTION

1st 24 hrs. Nat. _____
 1st 24 hrs. after shot _____
 Gas _____ Cu. Ft.
 Dry Hole _____
 Abandoned _____

Map No. _____ Sec. 28 Twp. 27 R. 4
 Well No. 76 Kramer Farm _____
Magalia Company _____

NORTH

WEST

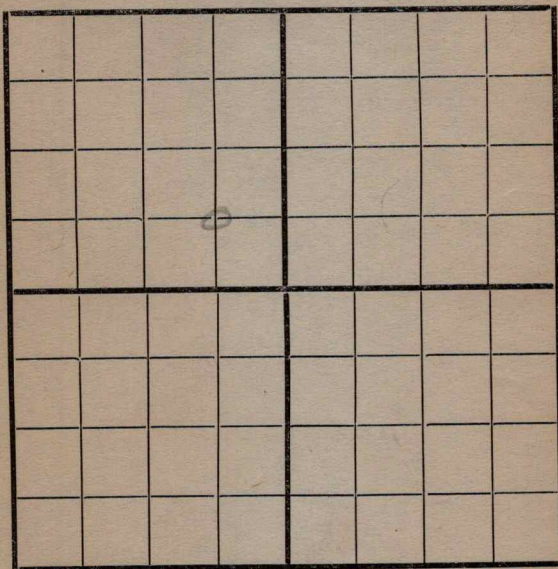

EAST

SOUTH

Location _____
 Rig Up ✓ _____
 Drilling and remarks _____

FIRST REPORT

RECORD

Cased _____ in. _____ Ft.
 Sand _____
 Gas _____
 Oil _____
 Total Depth _____

PRODUCTION

1st 24 hrs. Nat. _____
 1st 24 hrs. after shot _____
 Gas _____ Cu. Ft.
 Dry Hole _____
 Abandoned _____

Date

2/26 1912 Carley Scout
Rino


Map No. _____ Sec. 28 Twp. 27 R. 4

Well No. 16 Kramer Farm _____

Magnolia Company _____

NORTH

WEST

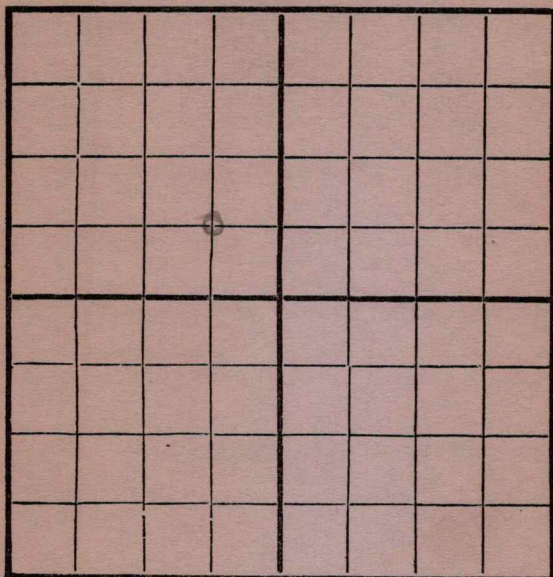

EAST

SOUTH

Location _____

Rig Up ☒ _____

Drilling and remarks _____

RECORD

Cased _____ in. _____ Ft.

Sand _____

Gas _____

Oil _____

Total Depth _____

PRODUCTION

1st 24 hrs. Nat. _____

First 24 hrs. after shot _____

Gas _____ Cu. Ft.

Dry Hole _____

Abandoned _____

Date

4/4, 1917 Co. D. Scout

Map No. _____ Sec. 28 Twp. 27 R. 4Well No. 16 _____ Farm _____Magnolia Company

NORTH

WEST

EAST

SOUTH

Location _____

Rig Up _____

Drilling and remarks _____

RECORD

Cased _____ in. _____ Ft.

Sand _____

Gas _____

Oil _____

Total Depth _____

PRODUCTION

1st 24 hrs. Nat. _____

1st 24 hrs. after shot _____

Gas _____ Cu. Ft.

Dry Hole _____


Abandoned _____

Date

4/10, 1912 Candy Scout

Map No. _____ Sec. 28 Twp. 27 R. 4
 Well No. 16 Kramer Farm
Maguire Company

NORTH

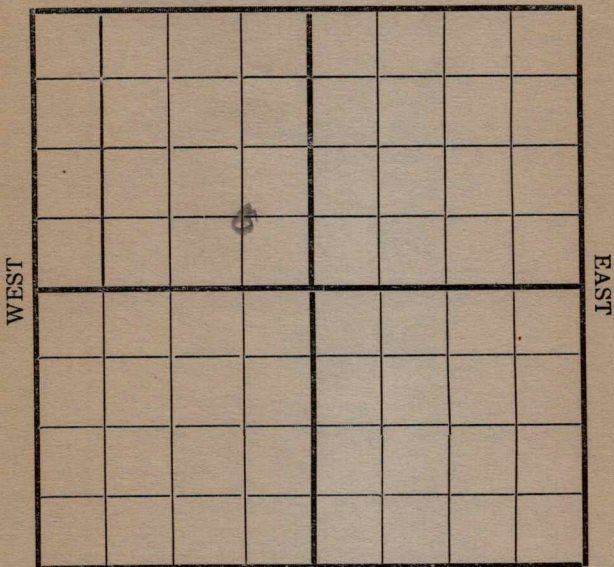

SOUTH

Location _____

Rig Up _____

Drilling and remarks

360'

RECORD

Cased _____ in. _____ Ft.

Sand _____

Gas _____

Oil _____

Total Depth _____

PRODUCTION

1st 24 hrs. Nat. _____

1st 24 hrs. after shot _____

Gas _____ Cu. Ft.

Dry Hole _____

Abandoned _____


Date

4/17, 1917 Scout

Map No. _____ Sec. 28 Twp. 27 R. 4Well No. 167 _____ Farm _____Marquell _____ Company _____

NORTH

WEST

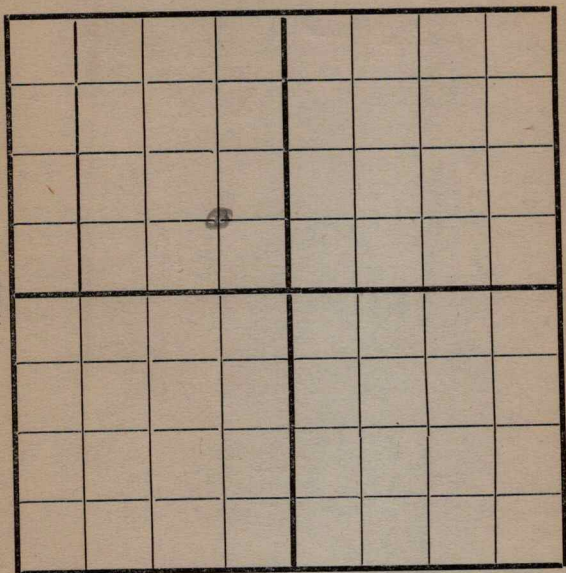

EAST

SOUTH

Location _____

Rig Up _____

Drilling and remarks

2500

RECORD

Cased _____ in. _____ Ft.

Sand _____

Gas _____

Oil _____

Total Depth _____

PRODUCTION

1st 24 hrs. Nat. _____

1st 24 hrs. after shot _____

Gas _____ Cu. Ft.

Dry Hole _____

Abandoned _____


Date

4/24 191 7 Carroll Scout

Map No. _____ Sec. 28 Twp. 27 R. 4
 Well No. 16 Kramer Farm
Mcguire Company

NORTH

WEST

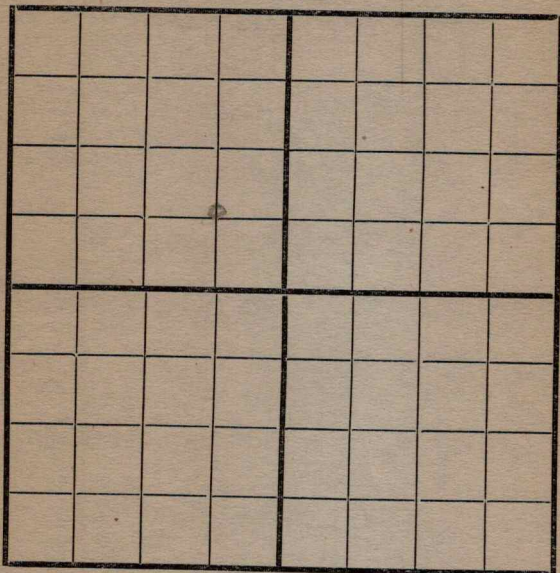

EAST

SOUTH

Location _____
 Rig Up _____
 Drilling and remarks _____

1465

RECORD

Cased _____ in. _____ Ft.
 Sand _____
 Gas _____
 Oil _____
 Total Depth _____

PRODUCTION


1st 24 hrs. Nat. _____
 1st 24 hrs. after shot _____
 Gas _____ Cu. Ft.
 Dry Hole _____
 Abandoned _____

Date

5/2, 1912 Card Scout

Map No. _____ Sec. 28 Twp. 27 R. 4
 Well No. 16 Kinner Farm _____
Magnolia Company _____

NORTH

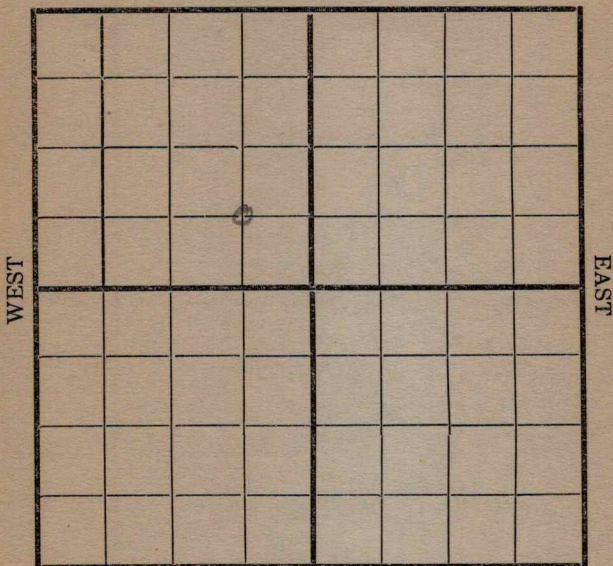

SOUTH

Location _____
 Rig Up _____
 Drilling and remarks _____

Shut Down
1465

RECORD

Cased _____ in. _____ Ft.
 Sand _____
 Gas _____
 Oil _____
 Total Depth _____

PRODUCTION

1st 24 hrs. Nat. _____
 1st 24 hrs. after shot _____
 Gas _____ Cu. Ft.
 Dry Hole _____
 Abandoned _____

Date


5/7, 1912 C. E. Jeff Scout

Map No. _____ Sec. 38 Twp. 27 R. 4

Well No. 16 Thru Farm _____
Maguolia Company

NORTH

WEST

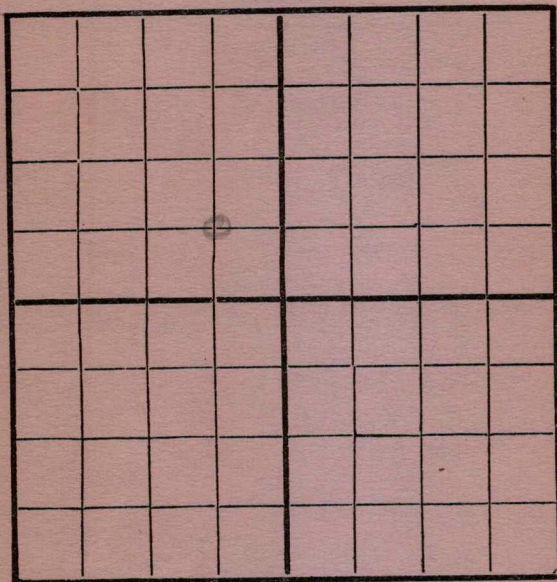

EAST

SOUTH

Location _____

Rig Up _____

Drilling and remarks

Shut Down
1465

RECORD

Cased _____ in. _____ Ft.

Sand _____

Gas _____

Oil _____

Total Depth _____

PRODUCTION

1st 24 hrs. Nat. _____

1st 24 hrs. after shot _____

Gas _____ Cu. Ft.

Dry Hole _____


Abandoned _____

Date

5/25-7 191 Carly Scout

Map No. _____ Sec. 28 Twp. 27 R. 4Well No. 16 Kinner FarmMagnolia Company

NORTH

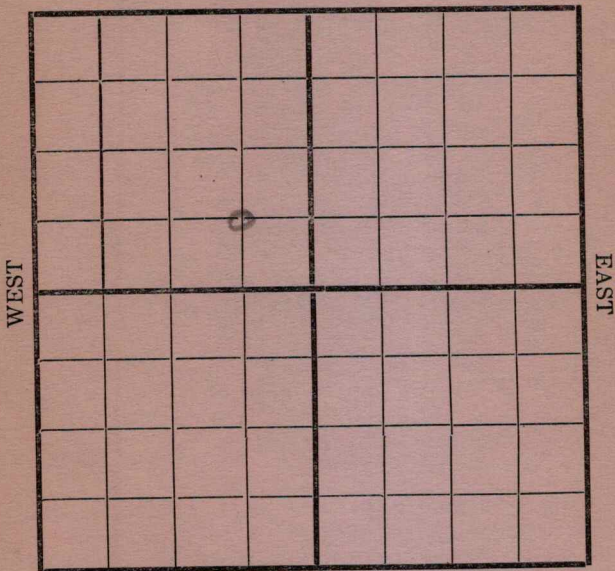

SOUTH

Location _____

Rig Up _____

Drilling and remarks

*Shut Down
for Corrosion
1465*

RECORD

Cased _____ in. _____ Ft.

Sand _____

Gas _____

Oil _____

Total Depth _____

PRODUCTION

1st 24 hrs. Nat. _____

1st 24 hrs. after shot _____

Gas _____ Cu. Ft.

Dry Hole _____


Abandoned _____

Date

5/29 191 7 Candiff Scout

Map No. _____ Sec. 28 Twp. 27 R. 4
 Well No. 16 Kipuna Farm _____
McGuire Company

NORTH

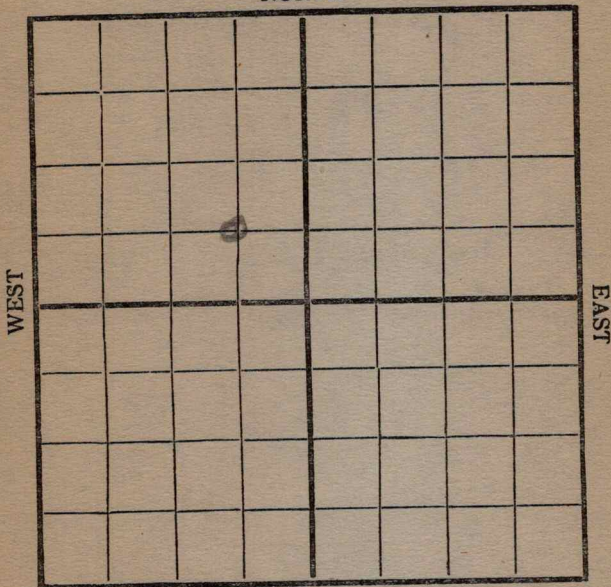

SOUTH

Location _____

Rig Up _____

Drilling and remarks

Shut Down
1465

RECORD

Cased _____ in. _____ Ft.

Sand _____

Gas _____

Oil _____

Total Depth _____

PRODUCTION

1st 24 hrs. Nat. _____

1st 24 hrs. after shot _____

Gas _____ Cu. Ft.


Dry Hole _____

Abandoned _____

Date

6/8, 191 *2*, *Canby* Scout

Map No. _____ Sec. 28 Twp. 27 R. 4
 Well No. 16 Kram Farm _____
Magnolia Company _____
 NORTH

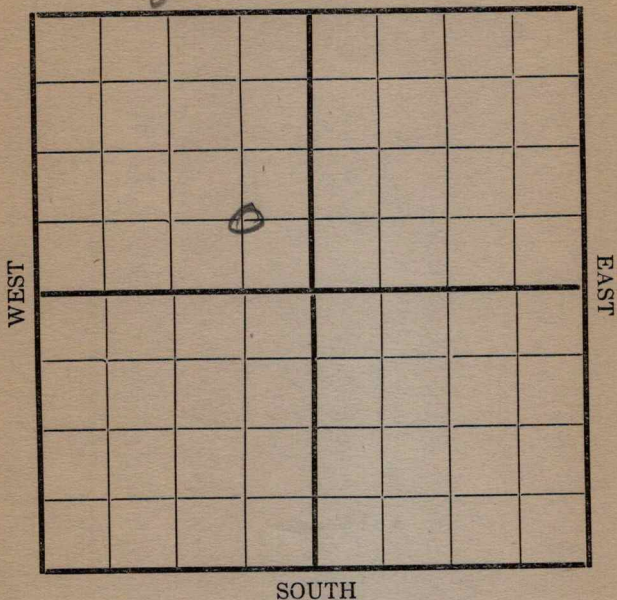

Location _____
 Rig Up _____
 Drilling and remarks _____

SD,
1465

RECORD

Cased _____ in. _____ Ft.
 Sand _____
 Gas _____
 Oil _____
 Total Depth _____

PRODUCTION


1st 24 hrs. Nat. _____
 1st 24 hrs. after shot _____
 Gas _____ Cu. Ft.
 Dry Hole _____
 Abandoned _____

Date

6/12, 1917 C. C. C. Scout

Map No. _____ Sec. 28 Twp. 27 R. 4Well No. 16 Kramer FarmMagnolia Company

NORTH

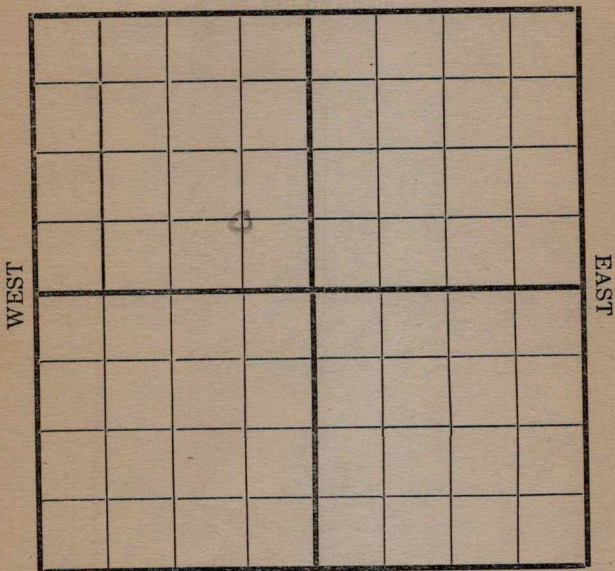

SOUTH

Location _____

Rig Up _____

Drilling and remarks

1725'

RECORD

Cased _____ in. _____ Ft.

Sand _____

Gas _____

Oil _____

Total Depth _____

PRODUCTION

1st 24 hrs. Nat. _____

1st 24 hrs. after shot _____

Gas _____ Cu. Ft.

Dry Hole _____


Abandoned _____

Date

6/30, 1917 Cond. Scout

Map No. _____ Sec. 28 Twp. 27 R. 4
 Well No. 16 Trainer Farm
Wingfield Company

NORTH

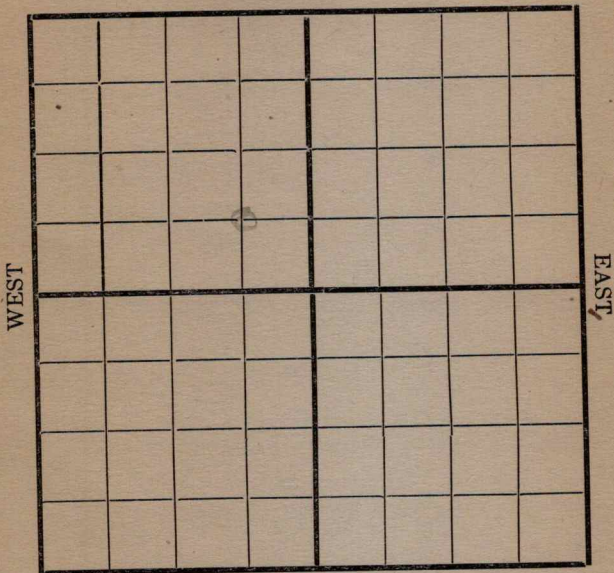

SOUTH

Location _____
 Rig Up _____
 Drilling and remarks _____

Shut
Down
1725

RECORD

Cased _____ in. _____ Ft.
 Sand _____
 Gas _____
 Oil _____
 Total Depth _____

PRODUCTION

1st 24 hrs. Nat. _____
 1st 24 hrs. after shot _____
 Gas _____ Cu. Ft.
 Dry Hole _____
 Abandoned _____

Date


6/27, 1917 7 Candiff Scout

Map No. _____ Sec. 28 Twp. 27 R. 4

Well No. 16 Trainer Farm _____
Superior Company _____

NORTH

WEST

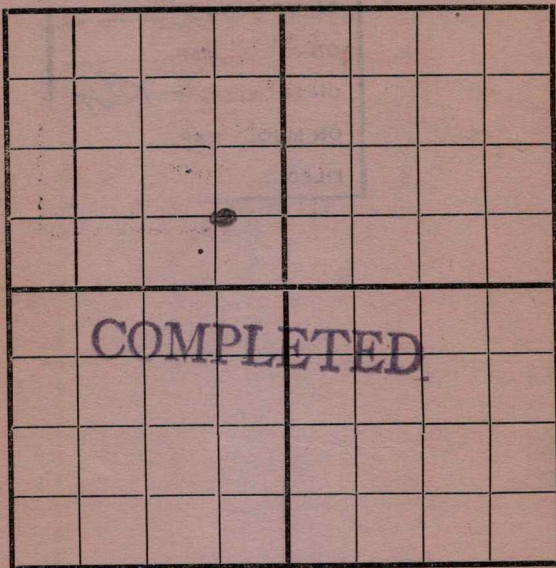

EAST

SOUTH

Location _____

Rig Up _____

Drilling and remarks

Est at
90 Bbls

RECORD

Cased _____ in. _____ Ft.

Sand 1928-1985

Gas _____

Oil _____

Total Depth _____

PRODUCTION

1st 24 hrs. Nat. _____

1st 24 hrs. after shot _____

Gas _____ Cu. Ft.

Dry Hole _____

Abandoned _____

Date

7/6, 1917 Candiff Scout