

KANSAS


Butler

FORM 51 5M 1-42 PETROL

Section 28 Township 27 Range 4-E


Well No. #17 Kramer

Company Magnolia

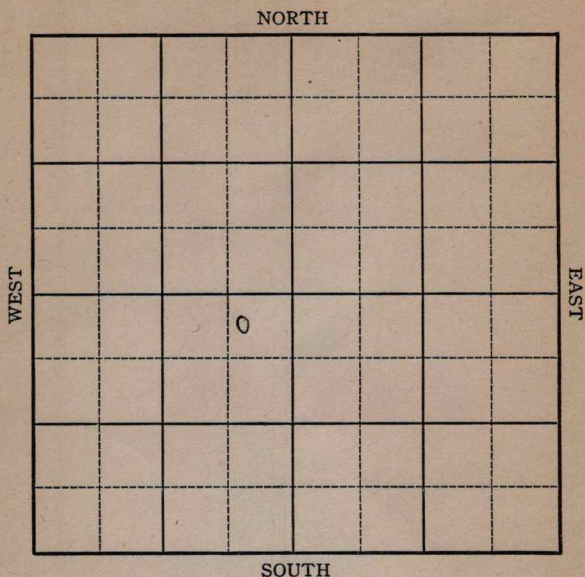

KANSAS

Butler

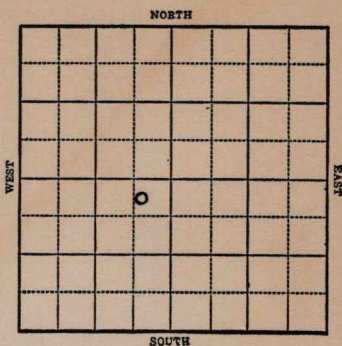Sec. 28 Twp. 27 R. 4-EWell No. #17 Kramer FarmMagnolia Company308 Ft. from N. Line Ft. from S. Line585 Ft. from E. Line Ft. from W. Line

1943

R E P O R T

5/19 Location

5/26 "

6/2 Cable rig

6/9 13" @ 20'

10" @ 407

Drlg. 585

6/16 8" @ 1474'

Drlg. 1520'

6/23 7 @ 1973' WOC.

Lans 1957'

6/30 5" @ 2191' S.D.

7/7 Lime 2368

Pay 2372-84 T.D

Est 25 oil a day

7/15 " " "

7/21 Lime 1957

5" @ 2191'

Lime 2368

Pay 2372-74

T.D. 2374'

Pump 38 Pot.

Gravity 36

COMPLETED

KANSAS
Map No. Sec. 28 Twp. 27 R. 4EWell No. 17 KramerMagnolia

Company

FIRST REPORT

Contractor

C N L N E S W

SECTION PLAT

308 Ft. from N. Line Ft. from S. Line585 Ft. from E. Line Ft. from W. Line

	0		

MISCELLANEOUS

Location XXXRig up

Drilling and Remarks:

RECORD

Cased in., ft.Sand Gas Oil Total Depth

PRODUCTION

1st 24 hrs. Nat. 1st 24 hrs. after shot Gas Cu. Ft.Dry Hole Abandoned

Date

MAY 19 1943

19

S. J. LEWIS

Scout

KANSASMap No. 1 Sec. 28 Twp. 27 R. 4EWell No. 17 KramerMagnolia CompanyCOMPLETED Contractor

SECTION PLAT

308 ^{C N L NE SW}
Ft. from N. Line Ft. from S. Line585 Ft. from E. Line Ft. from W. Line

MISCL.

	0		

Location Rig up

Drilling and Remarks:

*Levin 2 1957**5" @ 2191**Levin 2 2368**Prod 2372-74**Prod 38 P & X**360/44*

RECORD

Cased in., ft.Sand Gas Oil Total Depth 2374

PRODUCTION

1st 24 hrs. Nat. 1st 24 hrs. after shot Gas Cu. Ft.Dry Hole Abandoned

Date

JUL 21 1943

19

S. J. LEWIS Scout