


Section 19 Township 23 Range 4E

Well No. #1 Scrivner

Company H. V. Elwell

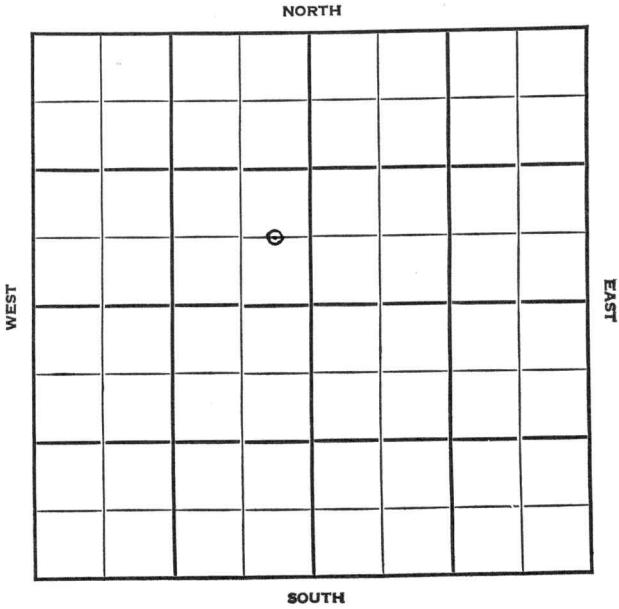


Sec. 19 Twp. 23 R. 4EWell No. #1 Scrivner FarmH. V. Elwell Company

Misc.

 Ft. from N. Line660 Ft. from S. Line330 Ft. from E. Line Ft. from W. Line

C E L SE NW

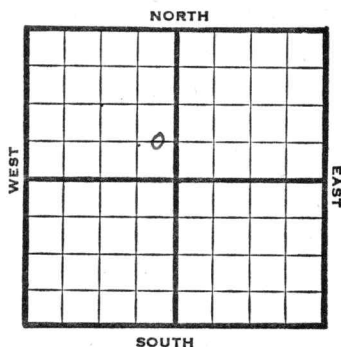

1948

Elev. 1414' REPORT

1/28 Drlg. 385'

2/4 10" @ 1025'
Drlg. 1375'2/11 10" @ 1885'
KC 2035'
Drlg. 2040'2/18 8" @ 2267'
Drlg 2310'2/25 Mississippi 2352-54'
TD 2354'
7" @ 2352'
RUST3/3 Miss. 2352'
7" @ 2352'
Pump 35 Pot
Gr. 380
Total Depth 2455'
COMPLETED

Map No. _____ Sec. 19 Twp. 23 R. 4E


Well No. 1 Scrivner _____

H. V. Elwell _____ Company

FIRST REPORT _____ Contractor

C E L S E N W

SECTION PLAT

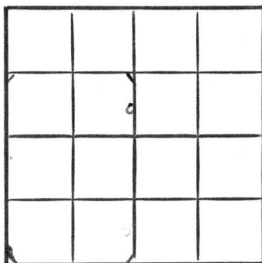

_____ Ft. from N. Line

660 Ft. from S. Line

330 Ft. from E. Line

_____ Ft. from W. Line

Butler County

Location _____

Rig up _____

Drilling and Remarks:

drlg. 385

RECORD

Cased _____ in., _____ ft.

Sand _____

Gas _____

Oil _____

Total Depth _____

PRODUCTION

1st 24 hrs. Nat. _____

1st 24 hrs. after shot _____

Gas _____ Cu. Ft.

Dry Hole _____

Abandoned _____

Date

JAN 28 1948

19

S. J. LEWIS

Scout

Kansas

Miscellaneous

Map No. 14 Sec. 19 Twp. 23 R. 4EWell No. 1 ScrivnerH. V. Elwell Company**COMPLETE**

Contractor

C E L S E N W

21.1414
SECTION PLAT

 Ft. from N. Line660 Ft. from S. Line330 Ft. from E. Line Ft. from W. LineButler CountyLocation Rig up

Drilling and Remarks:

Mis 23527" @ 2352Pump 350 BXCS-2**RECORD**Cased in., ft.Sand Gas Oil Total Depth 2352**PRODUCTION**1st 24 hrs. Nat. 1st 24 hrs. after shot Gas Cu. Ft.Dry Hole Abandoned

Date

MAR 3 1948

19

S. J. LEWIS

Scout