


Map No. _____ Sec. 8 Twp. 26 R. 5
 Well No. 15 Anderson Farm
Empire Company

NORTH

WEST

EAST

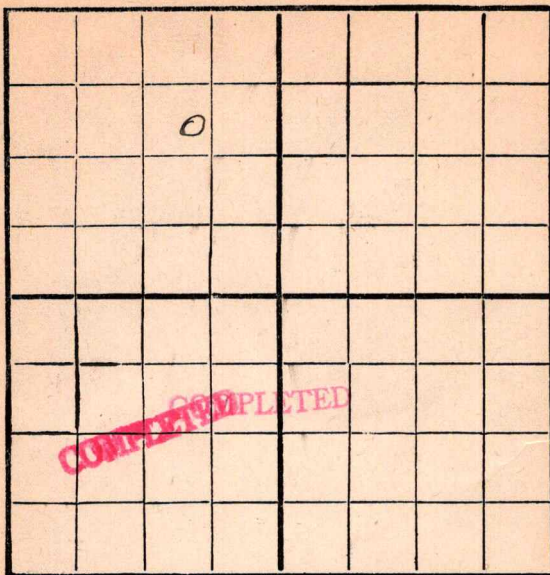

SOUTH

Location _____

Rig Up _____

Drilling Remarks:

Drilling Remarks:

20 bbls
in 10 hours

RECORD

Cased _____ in. _____ ft.

Sand 2415-2445

Gas _____

Oil _____

Total Depth _____

PRODUCTION

1st 24 hrs. Nat. _____

1st 24 hrs. after shot _____


Gas _____ cu. ft.

Dry Hole _____

Abandoned _____

Map No. K14 Sec. 8 Twp. 26 R. 5
 Well No. 15 Anderson
Empire Company
 Contractor

NORTH

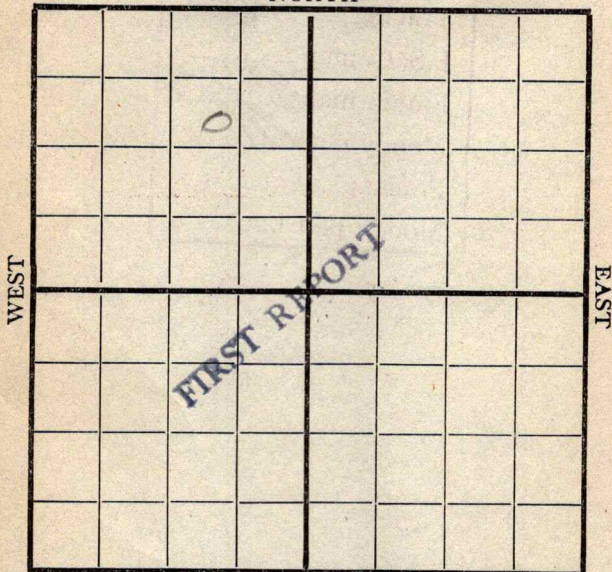

SOUTH

960 E

1050 N

Location _____

Rig up _____

Drilling and Remarks:

865'

RECORD

Cased _____ in., _____ ft.

Sand _____

Gas _____

Oil _____

Total Depth _____

PRODUCTION

1st 24 hrs. Nat. _____

1st 24 hrs. after shot _____

Gas _____ Cu. Ft.

Dry Hole _____

Abandoned _____

Date

6/3

191

9

Pyle

Scout

Map No. K 14 Sec. 8 Twp. 26 R. 5
 Well No. 15 Anderson
Empire Company
 Contractor

NORTH

WEST

EAST

COMPLETED

SOUTH

960 E

1050 N

Location _____

Rig up _____

Drilling and Remarks:

20 bbls
 in
 10 hrs

RECORD

Cased _____ in., _____ ft.

Sand 2415-2445

Gas _____

Oil _____

Total Depth _____

PRODUCTION

1st 24 hrs. Nat. _____

1st 24 hrs. after shot _____

Gas _____ Cu. Ft.

Dry Hole _____

Abandoned _____

Date

1919

Scout