


Map No. K 14 Sec. # 8 Twp. 26 R. 5Well No. 13 Anderson FarmEmpire Company

NORTH

WEST

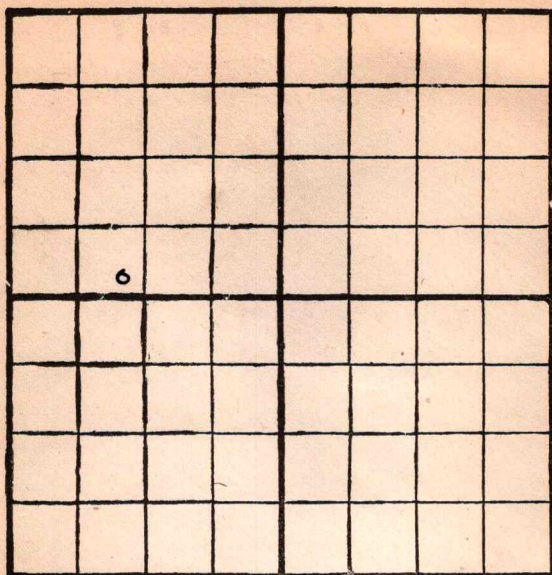

EAST

SOUTH

Location -----

Rig Up -----

Drilling Remarks:

Drilling Remarks:

RECORD

PRODUCTION

Cased ----- in. ----- ft.

1st 24 hrs. Nat. -----

Sand -----

1st 24 hrs. after shot -----

Gas -----

Gas ----- cu. ft.

Oil -----

Dry Hole -----

Total Depth -----


Abandoned -----

Map No. K 14 Sec. 8 Twp. 26 R. 5
 Well No. 13 Anderson
Empire _____ Company _____
 _____ Contractor

NORTH

WEST

EAST

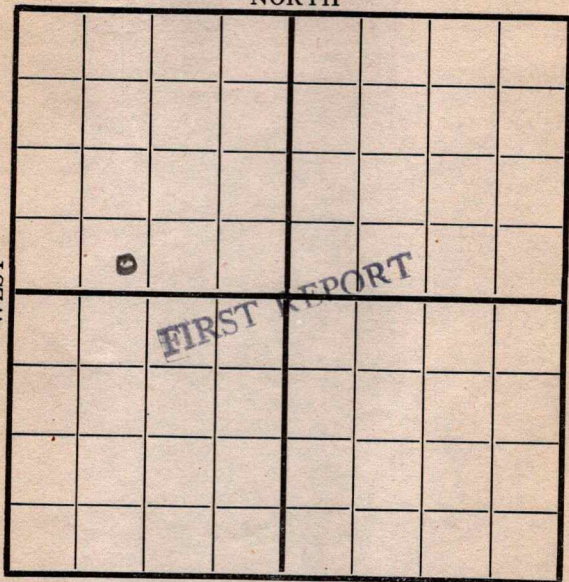

250 S

SOUTH

954 W

Location _____

Rig up ☒

Drilling and Remarks:

RECORD

Cased _____ in., _____ ft.

Sand _____

Gas _____

Oil _____

Total Depth _____

PRODUCTION

1st 24 hrs. Nat. _____

1st 24 hrs. after shot _____

Gas _____ Cu. Ft.

Dry Hole _____

Abandoned _____

Date

Pyle

191

9

Scout

Map No. K14 Sec. 8 Twp. 26 R. 5Well No. 13 AndersonEmpire Company

Contractor

NORTH

WEST

EAST

COMPLETED

SOUTH

250.3954 W

Location

Rig up

Drilling and Remarks:

RECORD

Cased _____ in., _____ ft.

Sand 2413 - 2457

Gas _____

Oil _____

Total Depth _____

PRODUCTION

1st 24 hrs. Nat. 30 bbl

1st 24 hrs. after shot _____

Gas _____ Cu. Ft.

Dry Hole _____

Abandoned _____

Date

3/281919Pyle

Scout