


Map No. _____ Sec. 8 Twp. 26 R. 5Well No. 1 Baturan (Batman) Farm_____
Ensign Company

NORTH

WEST

EAST

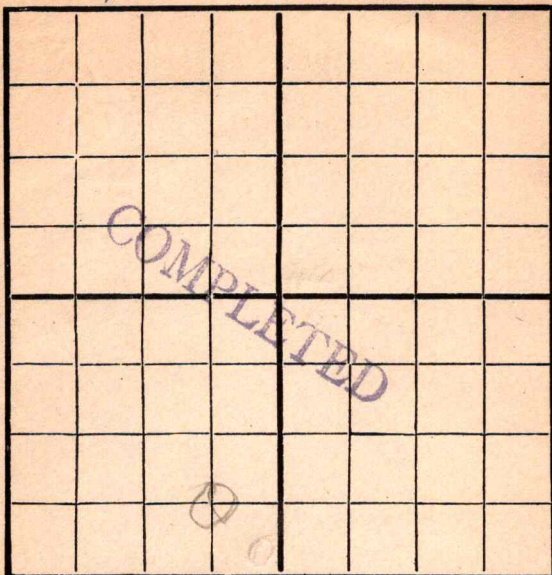

SOUTH

Location _____

Rig Up 7/29

Drilling Remarks

Drilling Remarks

10/3 - 130010/11 - 1580'10/18 - 1700' U. R. 10/251800: F = 11/92050 = 11/142135 = 11/27 - 12/42310 = 12/11 - 12/182355 = 12/282415 U. R. = 1/11 - 1/82415 = 1/15

RECORD

PRODUCTION

Cased _____ in. _____ Ft.

1st 24 hrs. Nat. _____

Sand _____

1st 24 hrs. after shot _____

Gas _____

Gas _____ Cu. Ft.

Oil _____


Dry Hole _____

Total Depth _____

Abandoned _____

Map No. _____ Sec. 8 Twp. 26 R. 5Well No. 1 Burton Farm _____Engine Company _____

NORTH

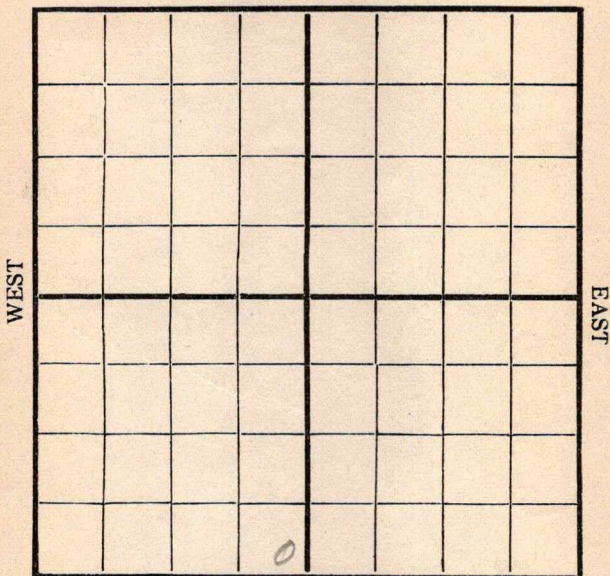

SOUTH

Location _____

Rig Up ☒ _____

Drilling and remarks _____

RECORD

Cased _____ in. _____ Ft.

Sand _____

Gas _____

Oil _____

Total Depth _____

PRODUCTION

1st 24 hrs. Nat. _____

1st 24 hrs. after shot _____

Gas _____ Cu. Ft.

Dry Hole _____

Abandoned _____

Date

7/29, 1916 McKendall Scout

Map No. _____ Sec. 8 Twp. 26 R. 5
 Well No. 1 Bateman Farm _____
Amphine Company _____

NORTH

WEST

EAST

SOUTH

Location ✓Rig Up ✓

Drilling and remarks

Location
Corrected

RECORD

Cased _____ in. _____

Sand _____

Gas _____

Oil _____

Total Depth _____

PRODUCTION

1st 24 hrs. Nat. _____

1st 24 hrs. after shot _____

Gas _____ Cu. Ft.

Dry Hole _____

Abandoned _____

Date


8/9, 1916 B. C. Clenduff Scout

Map No. _____ Sec. 8 Twp. 26 R. 5
 Well No. 1 Bottom Farm _____
Empire Company _____

NORTH

WEST

EAST

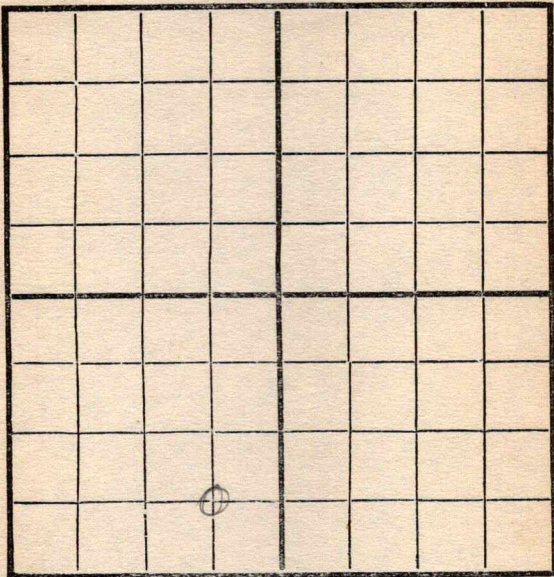

SOUTH

Location _____

Rig Up _____

Drilling and remarks

Spudding

RECORD

Cased _____ in. _____ Ft.

Sand _____

Gas _____

Oil _____

Total Depth _____

PRODUCTION

1st 24 hrs. Nat. _____

First 24 hrs. after shot _____

Gas _____ Cu. Ft.

Dry Hole _____

Abandoned _____

Date


8/7, 1916 *S. C. C. C.* Scout _____

Map No. _____ Sec. 8 Twp. 26 R. 5
 Well No. 1 Bateman Farm _____
Quapine Company _____

NORTH

WEST

EAST

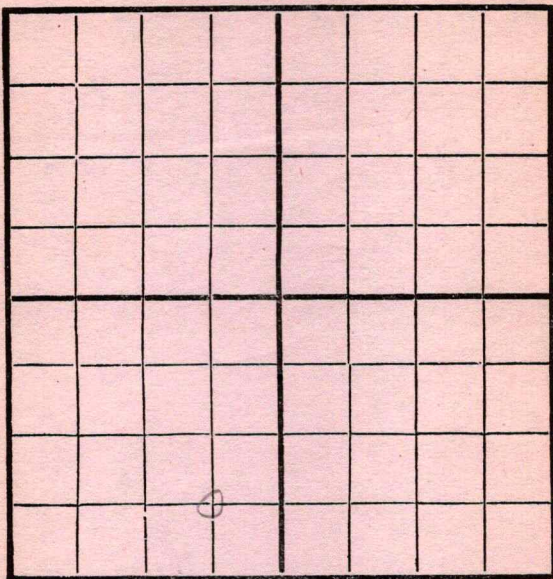

SOUTH

Location _____
 Rig Up _____
 Drilling and remarks _____

RECORD

Cased _____ in. _____ Ft.
 Sand _____
 Gas _____
 Oil _____
 Total Depth _____

PRODUCTION


1st 24 hrs. Nat. _____
 First 24 hrs. after shot _____
 Gas _____ Cu. Ft.
 Dry Hole _____
 Abandoned _____

Date

8/22, 1916 Reed Scout

Map No. _____ Sec. 8 Twp. 26 R. 5
 Well No. 1 Bateman Farm _____
E. M. Jones Company _____

NORTH

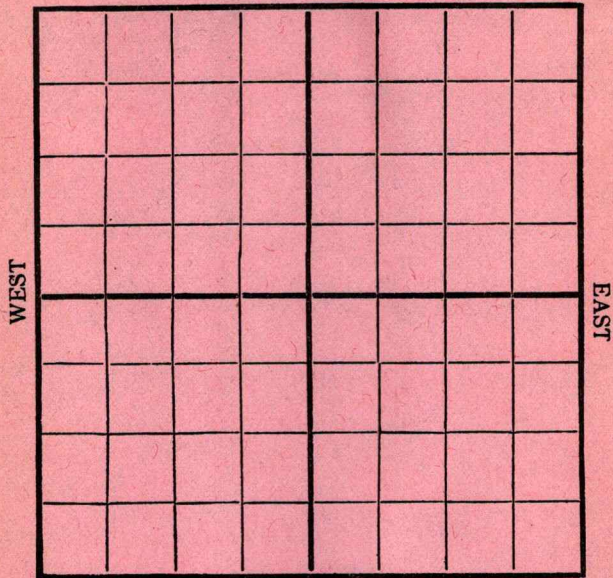

SOUTH

Location _____ Rig Up _____ Drilling and remarks <u>770</u>	RECORD
	Cased _____ in. _____ Ft.
	Sand _____
	Gas _____
	Oil _____
	Total Depth _____
	PRODUCTION
	1st 24 hrs. Nat. _____
	1st 24 hrs. after shot _____
	Gas _____ Cu. Ft.
	Dry Hole _____
	Abandoned _____

Date _____, 1919 April 29 Scout _____

Map No. _____ Sec. 8 Twp. 26 R. 5

Well No. 1 Bolton Farm

Empire Company

NORTH

WEST

EAST

SOUTH

Location _____

Rig Up _____

Drilling and remarks

1120

RECORD

Cased _____ in. _____ Ft.

Sand _____

Gas _____

Oil _____

Total Depth _____

PRODUCTION

1st 24 hrs. Nat. _____

1st 24 hrs. after shot _____

Gas _____ Cu. Ft.

Dry Hole _____

Abandoned _____

Date

9/6, 1916 G. Bailey Scout

Map No. _____ Sec. 8 Twp. 26 R. 5
 Well No. 1 Balmain Farm _____
Engine Company _____

NORTH

WEST

EAST

SOUTH

Location _____
 Rig Up _____
 Drilling and remarks _____

RECORD

Cased _____ in. _____ Ft.
 Sand _____
 Gas _____
 Oil _____
 Total Depth _____

PRODUCTION

1st 24 hrs. Nat. _____
 1st 24 hrs. after shot _____
 Gas _____ Cu. Ft.
 Dry Hole _____
 Abandoned _____

Date

11/30

Scout

Map No. _____ Sec. 8 Twp. 26 R. 5
 Well No. 1 Burton Farm _____
Quincy Company _____

NORTH

WEST

EAST

SOUTH

Location _____
 Rig Up _____
 Drilling and remarks _____

Shut Down

RECORD

Cased _____ in. _____ Ft.
 Sand _____
 Gas _____
 Oil _____
 Total Depth _____

PRODUCTION


1st 24 hrs. Nat. _____
 1st 24 hrs. after shot _____
 Gas _____ Cu. Ft.
 Dry Hole _____
 Abandoned _____

Date

9/20, 1916 *Scout* Scout _____

Map No. _____ Sec. 8 Twp. 26 R. 5
Well No. 1 Bathman Farm
Quapine Company

NORTH

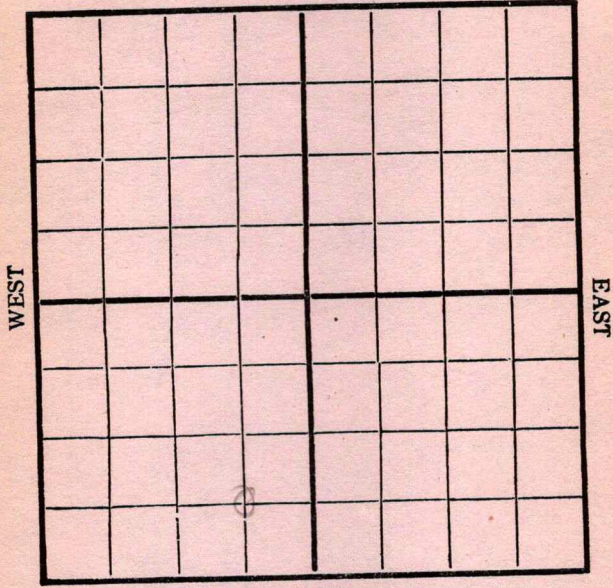

SOUTH

Location _____
Rig Up _____
Drilling and remarks
1265

RECORD

Cased _____ in. _____ Ft.
Sand _____
Gas _____
Oil _____
Total Depth _____

PRODUCTION

1st 24 hrs. Nat. _____
First 24 hrs. after shot _____
Gas _____ Cu. Ft.
Dry Hole _____
Abandoned _____

Date

9/26, 1916 Scout

Map No. _____ Sec. 8 Twp. 26 R. 5
 Well No. 1 Boston Farm _____
Engine Company _____

NORTH

WEST

EAST

SOUTH

Location _____

Rig Up _____

Drilling and remarks

1300

RECORD

Cased _____ in. _____ Ft.

Sand _____

Gas _____

Oil _____

Total Depth _____

PRODUCTION

1st 24 hrs. Nat. _____

1st 24 hrs. after shot _____

Gas _____ Cu. Ft.


Dry Hole _____

Abandoned _____

Date

10/3, 1916 Peckham Scout

Map No. _____ Sec. 8 Twp. 26 R. 5
Well No. 13 Farm _____
Empire Company _____
NORTH

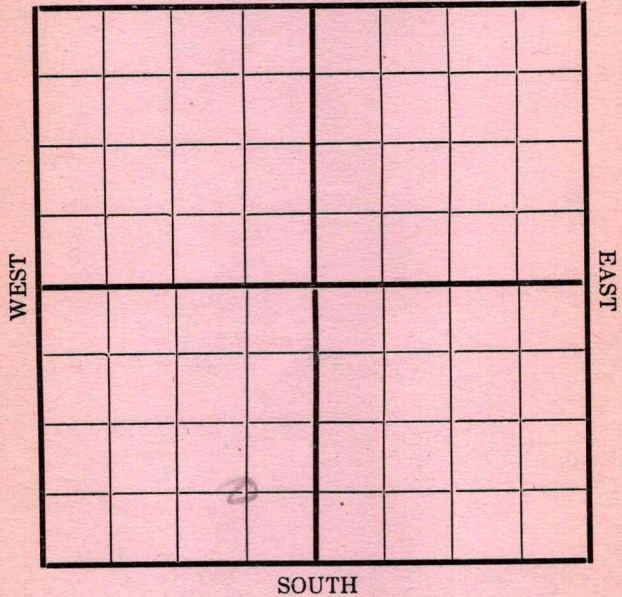

Location _____
Rig Up _____
Drilling and remarks
1580

RECORD
Cased _____ in. _____ Ft.
Sand _____
Gas _____
Oil _____
Total Depth _____

PRODUCTION
1st 24 hrs. Nat. _____
1st 24 hrs. after shot _____
Gas _____ Cu. Ft.
Dry Hole _____
Abandoned _____


Date 10/11, 1916 J. P. O'Connell Scout

Map No. _____ Sec. 8 Twp. 26 R. 5
 Well No. 1 Bateman Farm _____
Empire Company _____

NORTH

WEST

EAST

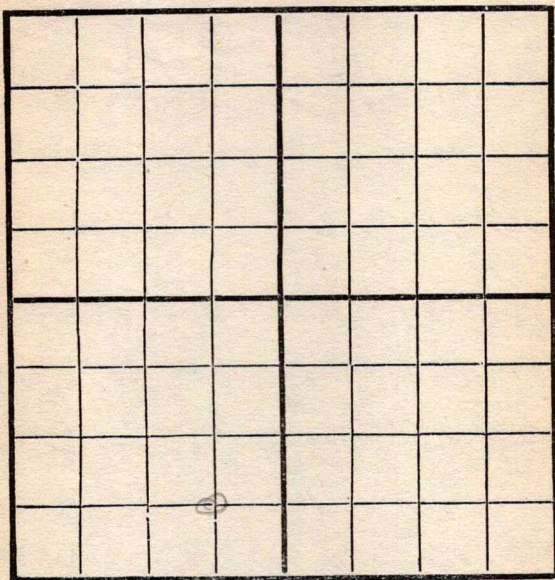

SOUTH

Location _____

Rig Up _____

Drilling and remarks

1700

RECORD

Cased _____ in. _____ Ft.

Sand _____

Gas _____

Oil _____

Total Depth _____

PRODUCTION

1st 24 hrs. Nat. _____

First 24 hrs. after shot _____

Gas _____ Cu. Ft.

Dry Hole _____

Abandoned _____

Date


10/18, 1916 W. H. C. C. C. Scout

Map No. _____ Sec. 8 Twp. 26 R. 5
Well No. 1 Bateman Farm _____
Camping Company _____

NORTH

WEST

EAST

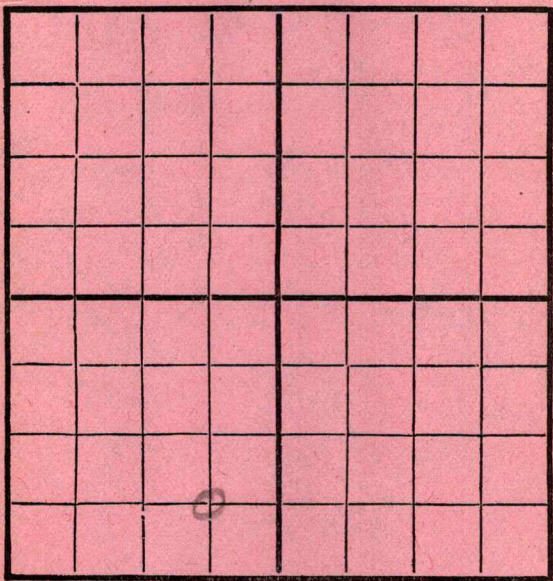

SOUTH

Location _____

Rig Up _____

Drilling and remarks

1700
under
running

RECORD

Cased _____ in. _____ Ft.

Sand _____

Gas _____

Oil _____

Total Depth _____

PRODUCTION

1st 24 hrs. Nat. _____

First 24 h.s. after shot _____

Gas _____ Cu. Ft.

Dry Hole _____

Abandoned _____

Date

10/25 191 6 L. C. Camp Scout

Map No. _____ Sec. 8 Twp. 26 R. 5


Well No. 1 Bottom Farm _____

_____ Company _____

NORTH

WEST

EAST

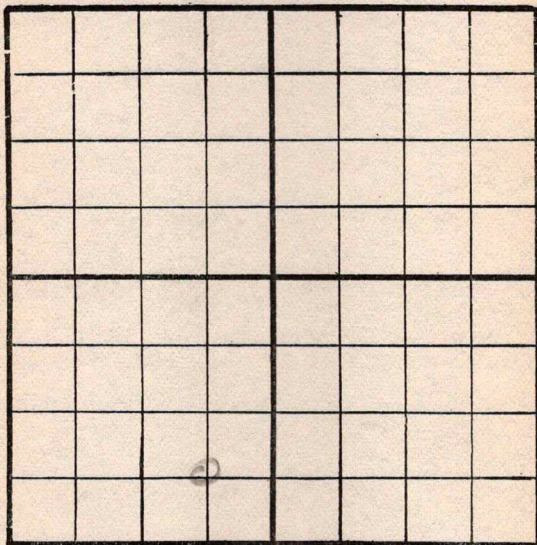

SOUTH

Location _____

Rig up _____

Drilling and remarks

1800

RECORD

Cased _____ in. _____ Ft.

Sand _____

Gas _____

Oil _____

Total Depth _____

PRODUCTION

1st. 24 hrs. Nat. _____

1st 24 hrs. after shot _____

Gas _____ Cu. Ft.

Dry Hole _____

Abandoned _____

Date

10/30, 1916, LLQ Scout

Map No. _____ Sec. 8 Twp. 26 R. 5Well No. 130 Farm _____

_____ Company _____

NORTH

WEST

EAST

SOUTH

Location _____

Rig Up _____

Drilling and remarks

RECORD

Cased _____ in. _____ Ft.

Sand _____

Gas _____

Oil _____

Total Depth _____

PRODUCTION

1st 24 hrs. Nat. _____

1st 24 hrs. after shot _____

Gas _____ Cu. Ft.

Dry Hole _____

Abandoned _____

Date


11/8, 1916 Scout

Map No. _____ Sec. 8 Twp. 26 R. 5
 Well No. 130 Farm _____
Company Company _____

NORTH

WEST

EAST

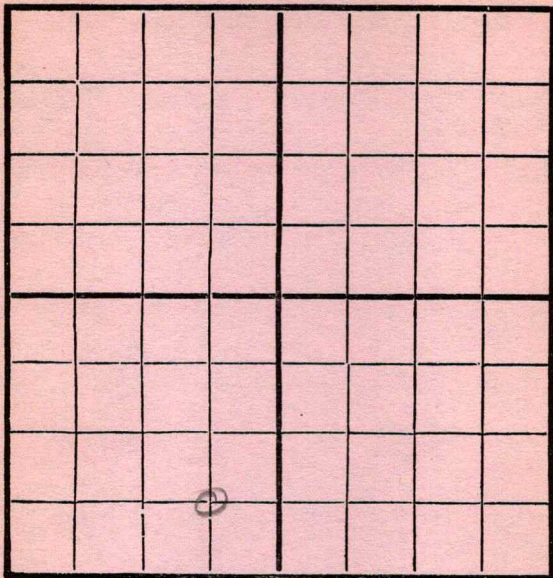

SOUTH

Location _____

Rig Up _____

Drilling and remarks

2050

RECORD

Cased _____ in. _____ Ft.

Sand _____

Gas _____

Oil _____

Total Depth _____

PRODUCTION

1st 24 hrs. Nat. _____

First 24 hrs. after shot _____

Gas _____ Cu. Ft.

Dry Hole _____

Abandoned _____

Date

11/14, 1916C. C. Cady


Scout

Map No. _____ Sec. 8 Twp. 26 R. 5
Well No. 1 Buttman Farm
Camp Company

NORTH

WEST

EAST

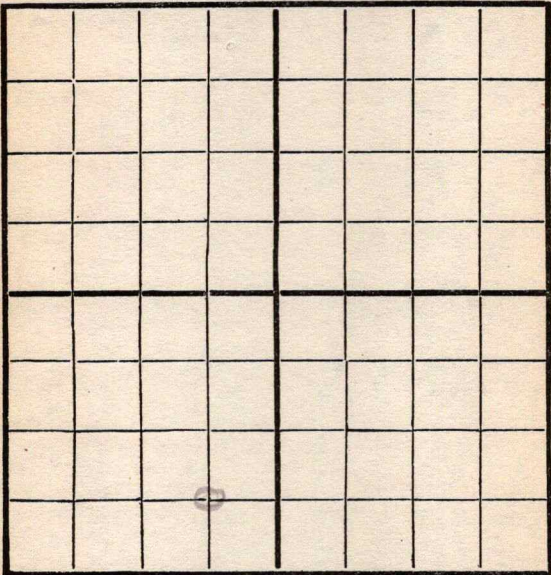

SOUTH

Location _____
Rig Up _____
Drilling and remarks

2088

RECORD

Cased _____ in. _____ Ft.
Sand _____
Gas _____
Oil _____
Total Depth _____

PRODUCTION

1st 24 hrs. Nat. _____
1st 24 hrs. after shot _____
Gas _____ Cu. Ft.
Dry Hole _____
Abandoned _____


Date

11/20, 1916 Camp Scout

Map No. _____ Sec. 8 Twp. 26 R. 5
 Well No. 1 Boston Farm _____
6 Virginia Company _____

NORTH

WEST

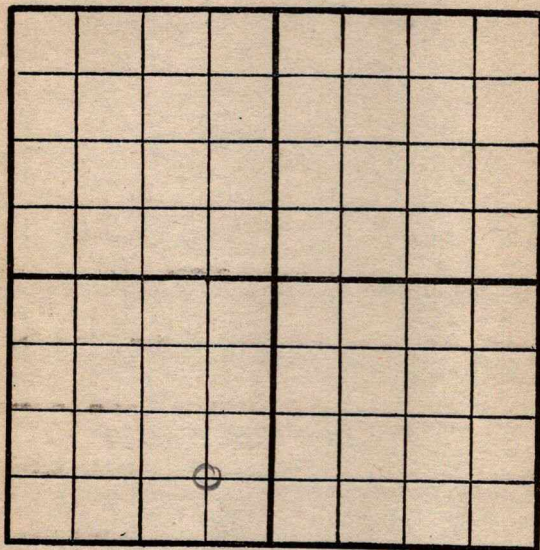

EAST

SOUTH

Location _____
 Rig Up _____
 Drilling and remarks

2135

RECORD

Cased _____ in. _____ Ft.
 Sand _____
 Gas _____
 Oil _____
 Total Depth _____

PRODUCTION

1st 24 hrs. Nat. _____
 1st 24 hrs. after shot _____
 Gas _____ Cu. Ft.
 Dry Hole _____
 Abandoned _____


Date

11/22, 1916 Candiff Scout

Map No. _____ Sec. 8 Twp. 26 R. 5
 Well No. 1 Bateman Farm _____
Empire Company _____

NORTH

WEST

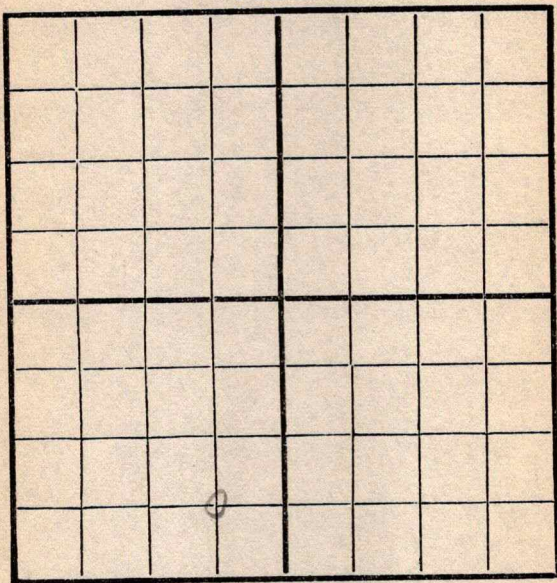

EAST

SOUTH

RECORD

Location _____

Cased _____ in. _____ Ft.

Rig Up _____

Sand _____

Drilling and remarks

Gas _____

Oil _____

Total Depth _____

PRODUCTION

1st 24 hrs. Nat. _____

1st 24 hrs. after shot _____

Gas _____ Cu. Ft.

Dry Hole _____

Abandoned _____

Date

12/4/1916 _____ Scout

Map No. _____ Sec. 8 Twp. 26 R. 5Well No. 1130 Farm _____

_____ Company _____

NORTH

WEST

EAST

SOUTH

Location _____

Rig Up _____

Drilling and remarks

2310'

RECORD

Cased _____ in. _____ Ft.

Sand _____

Gas _____

Oil _____

Total Depth _____

PRODUCTION

1st 24 hrs. Nat. _____

1st 24 hrs. after shot _____

Gas _____ Cu. Ft.

Dry Hole _____


Abandoned _____

Date

12/11, 1916 Conroy Scout

Map No. _____ Sec. 8 Twp. 26 R. 5
 Well No. 1130 Farm _____
Empire Company _____

NORTH

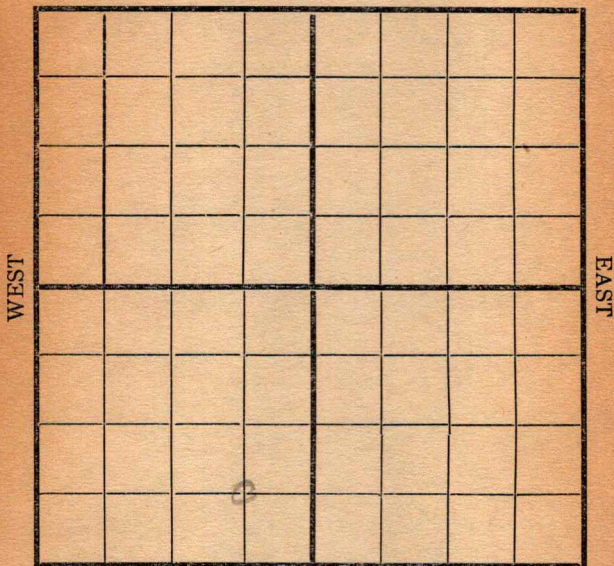

SOUTH

Location _____
 Rig Up _____
 Drilling and remarks _____

RECORD

Cased _____ in. _____ Ft.
 Sand _____
 Gas _____
 Oil _____
 Total Depth _____

PRODUCTION

1st 24 hrs. Nat. _____
 1st 24 hrs. after shot _____
 Gas _____ Cu. Ft.
 Dry Hole _____
 Abandoned _____


Date 12/18/1916

C. A. D. S. Scout

Map No. _____ Sec. 8 Twp. 26 R. 5
Well No. 1 Botwin Far _____
Amur _____ Company

NORTH

WEST

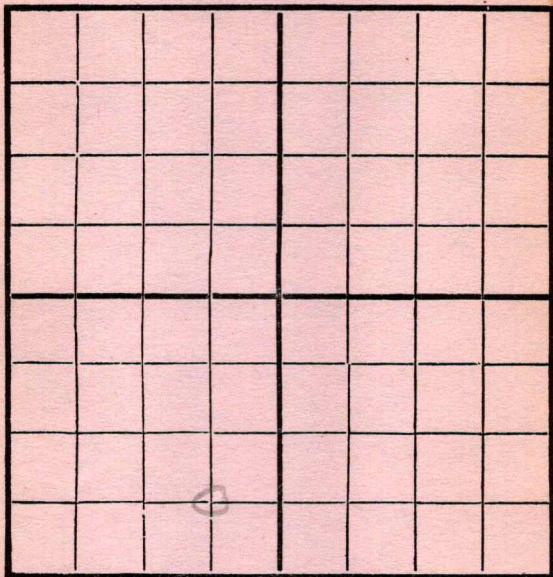

EAST

SOUTH

Location _____
Rig Up _____
Drilling and remarks _____

RECORD

Cased _____ in. _____ F
Sand _____
Gas _____
Oil _____
Total Depth _____

PRODUCTION

1st 24 hrs. Nat. _____
First 24 hrs. after shot _____
Gas _____ Cu. F
Dry Hole _____
Abandoned _____

Date

12/28 191 6

Carby Score _____

Map No. _____ Sec. 8 Twp. 26 R. 5
 Well No. 1 Bateman Farm _____
Barfield Company _____

NORTH

WEST

EAST

SOUTH

Location _____
 Rig Up _____
 Drilling and remarks _____

RECORD

Cased _____ in. _____ Ft.
 Sand _____
 Gas _____
 Oil _____
 Total Depth _____

PRODUCTION

1st 24 hrs. Nat. _____
 First 24 hrs. after shot _____
 Gas _____ Cu. Ft.
 Dry Hole _____
 Abandoned _____

Date

1/1, 1917 Cochise Scout _____

Map No. _____ Sec. 8 Twp. 26 R. 5
 Well No. 1 Bateman Farm _____
Carpine Company _____

NORTH

WEST

EAST

SOUTH

Location _____

Rig Up _____

Drilling and remarks

RECORD

Cased _____ in. _____ Ft.

Sand 2415

Gas _____

Oil _____

Total Depth _____

PRODUCTION

1st 24 hrs. Nat. _____

1st 24 hrs. after shot _____

Gas _____ Cu. Ft.

Dry Hole _____

Abandoned _____

Date

1/8, 1917 Carpine Scout _____

Map No. _____ Sec. 8 Twp. 26 R. 5Well No. 113 Farm _____Empire Company _____

NORTH

WEST

EAST

SOUTH

Location _____

Rig Up _____

Drilling and remarks

Fishing2415

RECORD

Cased _____ in. _____ Ft.

Sand _____

Gas _____

Oil _____

Total Depth _____

PRODUCTION

1st 24 hrs. Nat. _____

1st 24 hrs. after shot _____

Gas _____ Cu. Ft.

Dry Hole _____

Abandoned _____

Date


1/15, 1917 Card Scout _____

Map No. _____ Sec. 8 Twp. 26 R. 5
 Well No. 1 Botwin Farm _____
Engine Company _____

NORTH

WEST

EAST

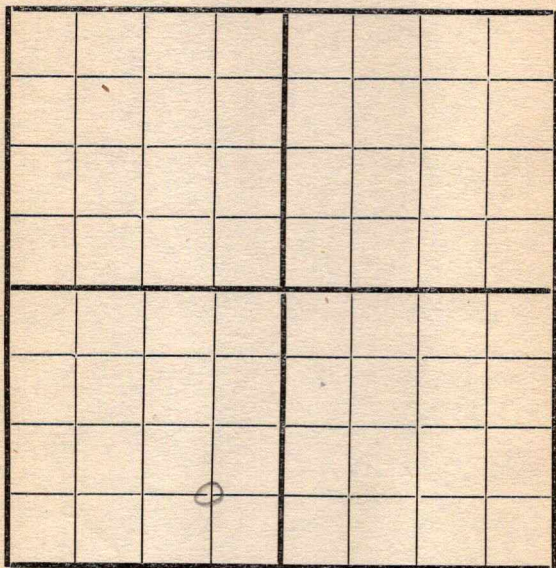

SOUTH

Location _____

Rig Up _____

Drilling and remarks

U.R.2415

RECORD

Cased _____ in. _____ Ft.

Sand _____

Gas _____

Oil _____

Total Depth _____

PRODUCTION

1st 24 hrs. Nat. _____

1st 24 hrs. after shot _____

Gas _____ Cu. Ft.

Dry Hole _____


Abandoned _____

Date

1/27, 1917 Condy Scout _____

Map No. _____ Sec. 8 Twp. 26 R. 5
 Well No. 1 Botwin Farm _____
Empire Company _____

NORTH

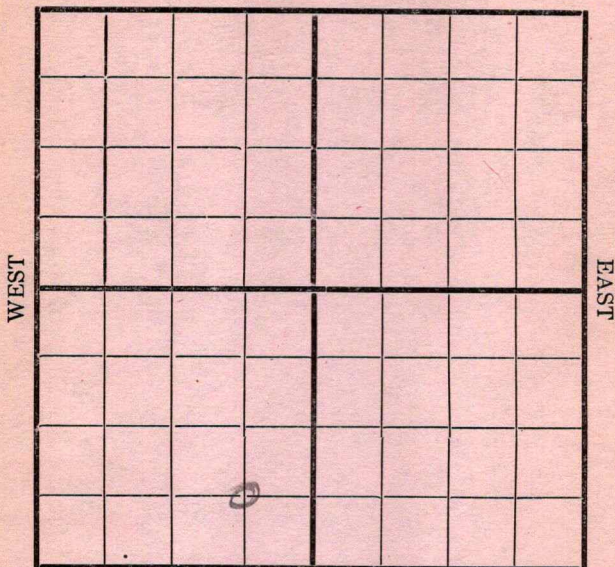

SOUTH

Location _____
 Rig Up _____
 Drilling and remarks _____

Under running
2415'

RECORD

Cased _____ in. _____ Ft.
 Sand _____
 Gas _____
 Oil _____
 Total Depth _____

PRODUCTION

1st 24 hrs. Nat. _____
 1st 24 hrs. after shot _____
 Gas _____ Cu. Ft.
 Dry Hole _____
 Abandoned _____


Date

1/29, 1917 Conley Scout

Map No. _____ Sec. 8 Twp. 26 R. 5
Well No. 1 Boston Farm _____
Empire Company _____

NORTH

WEST

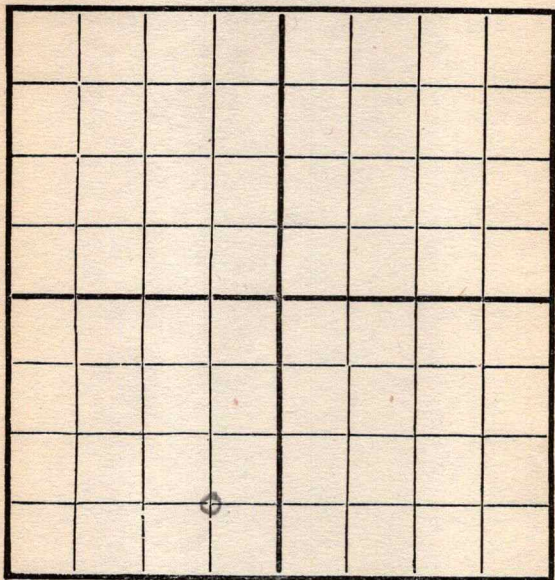

EAST

SOUTH

Location _____
Rig Up _____
Drilling and remarks _____

2436'

RECORD

Cased _____ in. _____ Ft.
Sand _____
Gas _____
Oil _____
Total Depth _____

PRODUCTION

1st 24 hrs. Nat. _____
First 24 hrs. after shot _____
Gas _____ Cu. Ft.
Dry Hole _____
Abandoned _____


Date 2/5, 1917 C. C. C. Scout _____

Map No. _____ Sec. 8 Twp. 26 R. 5
 Well No. 1 Batum Farm _____
Empire Company _____

NORTH

WEST

EAST

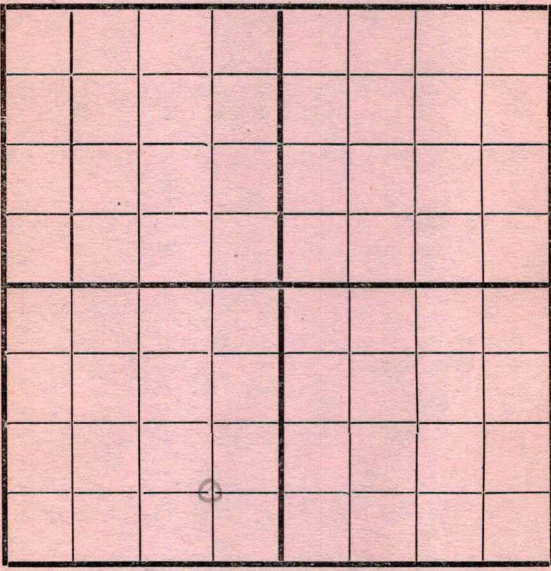

SOUTH

Location _____
 Rig Up _____
 Drilling and remarks _____

Shut Down
2436'

RECORD

Cased _____ in. _____ Ft.
 Sand _____
 Gas _____
 Oil _____
 Total Depth _____

PRODUCTION

1st 24 hrs. Nat. _____
 1st 24 hrs. after shot _____
 Gas _____ Cu. Ft.
 Dry Hole _____
 Abandoned _____

Date 9/2, 1917 Scout

Map No. _____ Sec. 8 Twp. 26 R. 5
 Well No. 1 Botman Farm _____
Empire Company _____

NORTH

WEST

EAST

COMPLETED

SOUTH

Location _____

Rig Up _____

Drilling and remarks

Est at
 2.50 Bbls

RECORD

Cased _____ in. _____ Ft.

Sand 2415-2462

Gas _____

Oil _____

Total Depth _____

PRODUCTION

1st 24 hrs. Nat. _____

First 24 hrs. after shot _____

Gas _____ Cu. Ft.

Dry Hole _____


Abandoned _____

Date

1227 191 Carley Scout

Map No. _____ Sec. 8 Twp. 26 R. 5
 Well No. Batman Farm _____
Engine Company _____

NORTH

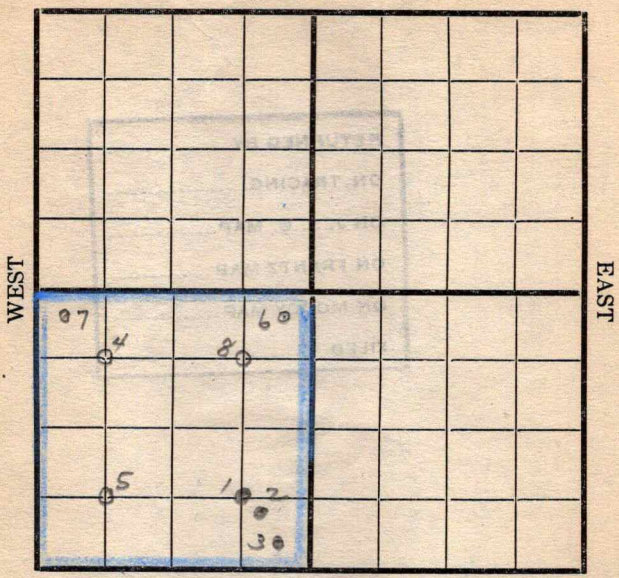

SOUTH

Location _____ Rig Up _____ Drilling and remarks _____	RECORD
	Cased _____ in. _____ Ft.
	Sand _____
	Gas _____
	Oil _____
	Total Depth _____
	PRODUCTION
	1st 24 hrs. Nat. _____
	1st 24 hrs. after shot _____
	Gas _____ Cu. Ft.
	Dry Hole _____
	Abandoned _____

Date _____, 191____ Scout _____