
Form 51—10M—8-19—CroMac

Map No. _____ Sec. 20 Twp. 23 R. 4

Well No. 9 Lennen Farm

Okee 1 & TP, Company

10

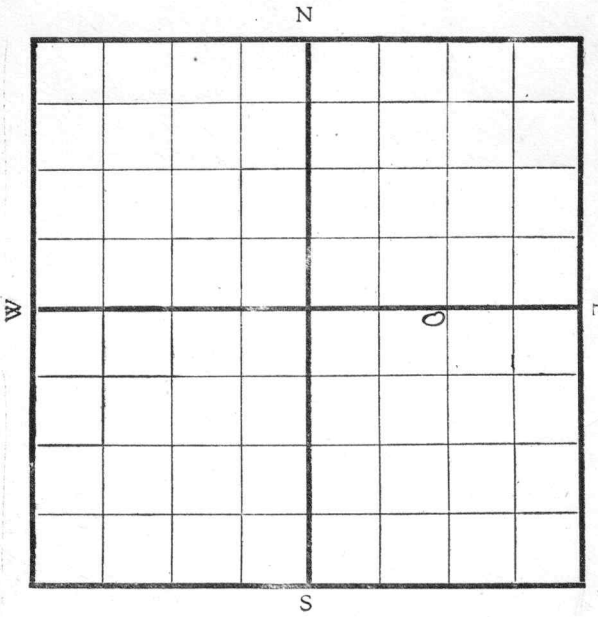

Location _____

Drilling Remarks:

COMPLETED

Rig Up _____

Drilling Remarks:

RECORD

Cased _____ in. _____ ft.

Sand _____

Gas _____

Oil _____

Total Depth _____

PRODUCTION

1st 24 hrs. Nat. _____

1st 24 hrs. after shot _____

Gas _____ cu. ft.

Dry Hole _____

Abandoned _____

Form 252A—6M-11-19-CroMac.

Map No. _____ Sec. 20 Twp. 5 3 R. 4

Well No. 9 Fewrier Farm


Okla P & R, Company

200 Ft. from N. Line

_____ Ft. from S. Line

_____ Ft. from E. Line

1120 Ft. from W. Line

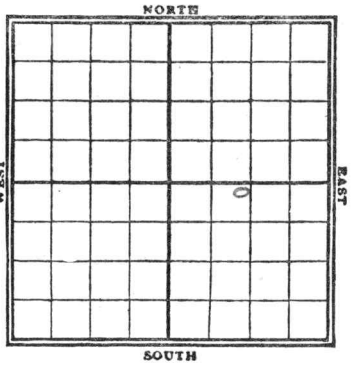

Date	REPORT
3/16	To S.
23	Rig
31	Rig up.
8	Rig
15	Tools
26	Spud
29	Drlg 600'
4/m	Sd 600
22	Abandoned 700'

FIRST REPORT

COMPLETED

Form 26—1M—4-19—Mid-West

Map No. K14 Sec. 20 Twp. 23 R. 4

Well No. 9 Ferrier

Okla. O. & G. Company

Contractor

SECTION PLAT



200 Ft. from N. Line

Ft. from S. Line

Ft. from E. Line

1120 Ft. from W. Line

Location

Rig up

Drilling and Remarks:

T. O. G.

RECORD

Cased in., ft.

Sand

Gas

Oil

Total Depth

PRODUCTION

1st 24 hrs. Nat.

1st 24 hrs. after shot

Gas Cu. Ft.

Dry Hole

Abandoned

Date

2/16 1920.

Pyle Scout

Butler

FORM 26 250 BKS. 4-28 WESTERN

K14

MAP NO. KANSAS SEC. 20 TWP. 735 R. 4E

WELL NO. 9 Fences


Okla. P & R.

COMPANY

CONTRACTOR

ABANDONED

SECTION PLAT

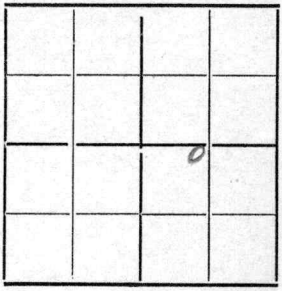

_____ FT. FROM N. LINE

_____ FT. FROM S. LINE

_____ FT. FROM E. LINE

_____ FT. FROM W. LINE

LOCATION _____

RIG UP _____

DRILLING AND REMARKS:

RECORD

CASED _____ IN., _____ FT.

SAND _____

GAS _____

OIL _____

TOTAL DEPTH 700

PRODUCTION

1ST 24 HRS. NAT. _____

1ST 24 HRS. AFTER SHOT _____

GAS _____ CU. FT.

DRY HOLE _____

ABANDONED ✓

DATE

4/19 1920

_____ SCOUT

Form 26—1M—4-19—Mid-West


Map No. K 14 Sec. 20 Twp. 23 R. 4

Well No. 9 Ferrier

Oklahoma P & R Co. Company

Contractor

SECTION PLAT

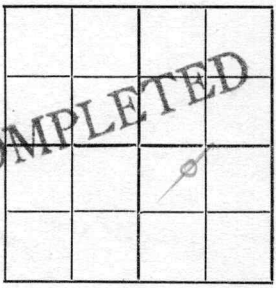

200 Ft. from N. Line

Ft. from S. Line

Ft. from E. Line

1120 Ft. from W. Line

Location

Rig up

Drilling and Remarks:

RECORD

Cased in., ft.

Sand

Gas

Oil

Total Depth

PRODUCTION

1st 24 hrs. Nat.

1st 24 hrs. after shot

Gas Cu. Ft.

Dry Hole

Abandoned 700

Date

4/22 1920

Pyle Scout