

Map No. _____ Sec. 8 Twp. 26 R. 5Well No. #10 Batman Farm __________Empire_____
Company

NORTH

WEST

EAST

SOUTH

COMPLETED

Location _____

Rig Up _____

Drilling Remarks:

Drilling Remarks:

RECORD

Cased _____ in. _____ ft.

Sand _____

Gas _____

Oil _____

Total Depth _____

PRODUCTION

1st 24 hrs. Nat. _____

1st 24 hrs. after shot _____


Gas _____ cu. ft.

Dry Hole _____

Abandoned _____

Map No. _____ Sec. 8 Twp. 26 R. 5Well No. 10 Batman Farm __________
Company

NORTH

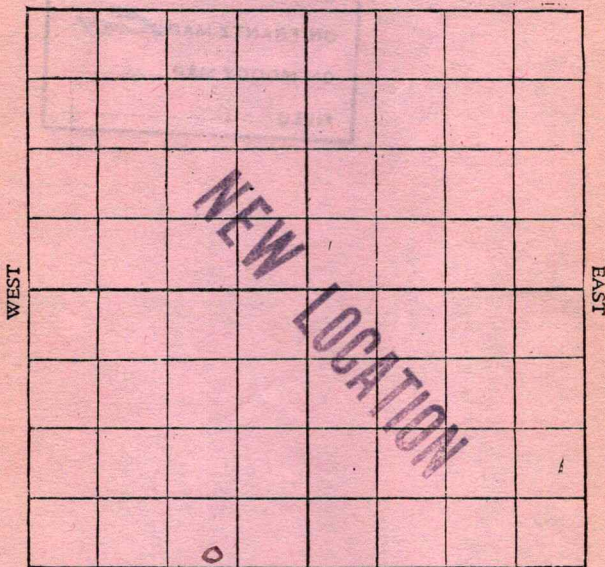

SOUTH

Location _____

Rig up ☒ _____

Drilling and remarks:

RECORD

Cased _____ in. _____ Ft.

Sand _____

Gas _____

Oil _____

Total Depth _____

PRODUCTION

1st 24 hrs. Nat. _____

1st 24 hrs. after shot _____

Gas _____ Cu. Ft.

Dry Hole _____

Abandoned _____

Date

JUL 3 1917

191

G. T. Crocker Scout

Map No. _____ Sec. 8 Twp. 26 R. 5Well No. 10 Bateman Farm_____Corp. Company

NORTH

WEST

EAST

SOUTH

Location _____

Rig up ☒

Drilling and remarks:

RECORD

Cased _____ in. _____ Ft.

Sand _____

Gas _____

Oil _____

Total Depth _____

PRODUCTION

1st 24 hrs. Nat. _____

1st 24 hrs. after shot _____

Gas _____ Cu. Ft.

Dry Hole _____

Abandoned _____

Date

JUL 14 1917


191

C. J. Crocker Scout

Map No. _____ Sec. 8 Twp. 16 R. 5Well No. 10. Bateman Farm
Empire Company

NORTH

WEST

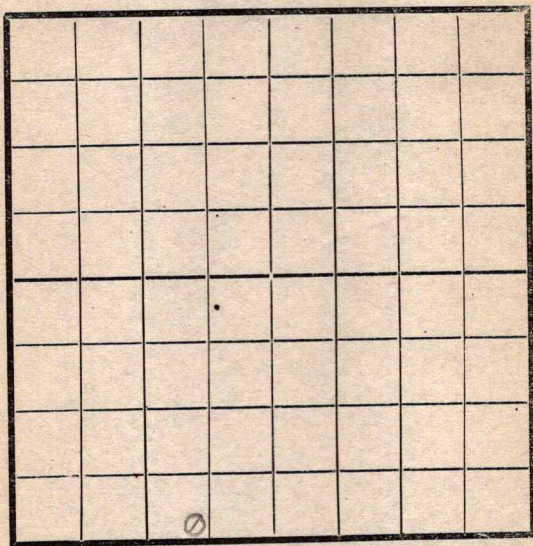

EAST

SOUTH

RECORD

Location _____

Cased _____ in. _____ Ft.

Rig Up _____

Sand _____

Drilling and remarks

Gas _____

Oil _____

Total Depth _____

PRODUCTION

1st 24 hrs. Nat. _____

1st 24 hrs. after shot _____

Gas _____ Cu. Ft.

Dry Hole _____


Abandoned _____

Date

8-13, 1917 Lantz Scout

Map No. _____ Sec. 8 Twp. 36 R. 5Well No. 10, Balmor FarmEngine Company

NORTH

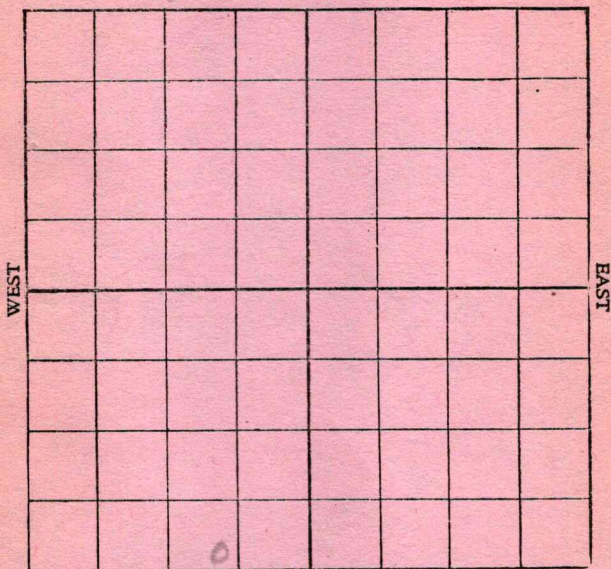

SOUTH

Location _____

Rig up _____

Drilling and remarks:

2380

RECORD

Cased _____ in. _____ Ft.

Sand _____

Gas _____

Oil _____

Total Depth _____

PRODUCTION

1st 24 hrs. Nat. _____

1st 24 hrs. after shot _____

Gas _____ Cu. Ft.

Dry Hole _____

Abandoned _____


Date

10/9, 1917, Cand Scout

Map No. _____ Sec. 8 Twp. 26 R. 5
 Well No. 10 Bateman Farm _____
Empire Company _____

NORTH

WEST

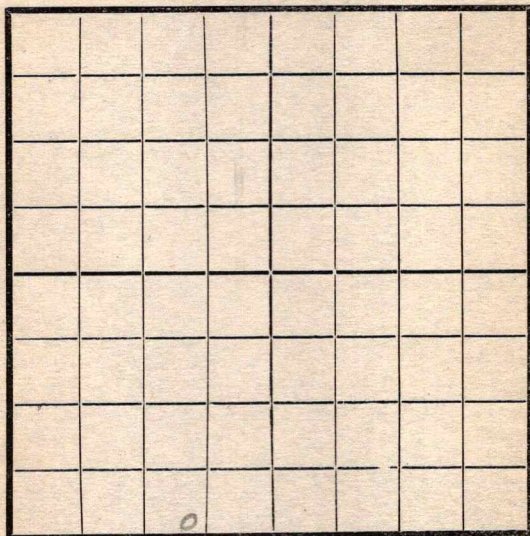

EAST

SOUTH

Location _____

Rig Up _____

Drilling and remarks

Top sand
2490

RECORD

Cased _____ in. _____ Ft.

Sand _____

Gas _____

Oil _____

Total Depth _____

PRODUCTION

1st 24 hrs. Nat. _____

1st 24 hrs. after shot _____

Gas _____ Cu. Ft.

Dry Hole _____

Abandoned _____

Date

10/17, 191*7* *7* *Carley* Scout _____


Map No. 11004 K14 Sec. 8 Twp. 26 R. 5

Well No. 10 Bateman Farm

Empire Company

NORTH

WEST

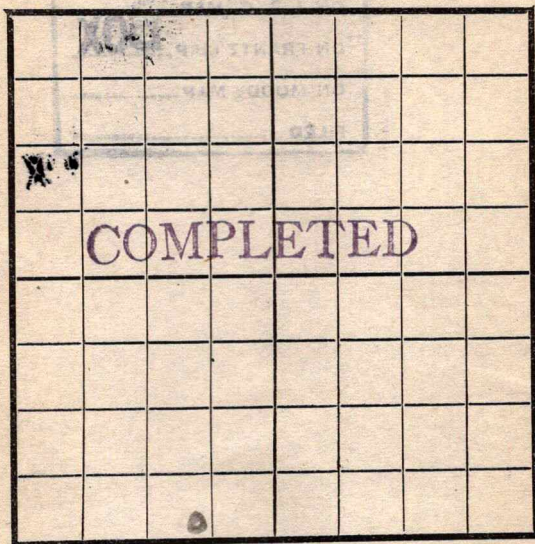

EAST

SOUTH

RECORD

Location -----

Rig Up -----

Drilling and remarks

Cased ----- in ----- Ft.

Sand 2424-2479

Gas -----

Oil -----

Total Depth -----

PRODUCTION

1st 24 hrs. Nat. -----

1st 24 hrs. after shot -----

Gas ----- Cu. Ft.

Dry Hole -----

Abandoned -----

Date

10/24, 1917. Conroy Scout