

Section 8 Township 26 Range 5E

Well No. 22 Batten *(Batman)*

Company Cities Service

Misc.

NORTH

WEST

EAST

0

SOUTH

KANSAS

Butler

✓

Sec. 8 Twp. 26 R. 5-EWell No. #22 Batten Farm

Cities Service Company

Miscellaneous


Ft. from N. Line

990' Ft. from S. Line

Ft. from E. Line

990' Ft. from W. Line

NE SW SW

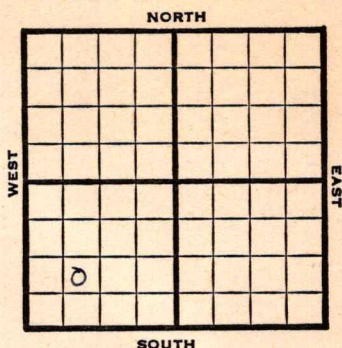

1947	Elev. 1475' REPORT
11/12	8" @ 42' Drlg. 80'
11/19	Arbuckle 2416' TD 2417' 5" @ 2416'
11/25	"
12/3	TD 2468' 80 qts. 2432'-64' CO
12/10	Pump 20 bbls. oil / 59 W in 12 hrs.
12/30	Cong. 2411' Arb. 2416' 5" @ 2416' 80 qts. Pump 47 oil / 25 W pot 38.0 Gr. TD 2468'

COMPLETED

Form 26 200 Bks. 10-46 Petrol
KansasMap No. _____ Sec. 8 Twp. 26 R. 5EWell No. 22 Batten

_____ Cities Service _____ Company

_____ FIRST REPORT _____ Contractor

NE SW SW

SECTION PLAT

_____ Ft. from N. Line

990 Ft. from S. Line

_____ Ft. from E. Line

990 Ft. from W. Line

6			

Butler County

Location _____

Rig up _____

Drilling and Remarks:

8" @ 42

drlg. 80

RECORD

Cased _____ in., _____ ft.

Sand _____

Gas _____

Oil _____

Total Depth _____

PRODUCTION

1st 24 hrs. Nat. _____

1st 24 hrs. after shot _____

Gas _____ Cu. Ft.

Dry Hole _____

Abandoned _____

Date

NOV 11 1947

19

S. J. LEWIS

Scout

Kansas

Map No. 14 Sec. 8 Twp. 26 R. 5EWell No. 22 Batten


Cities Service

Company

COMPLETE

Contractor

NE SW SW

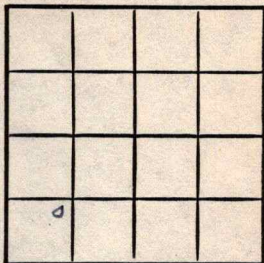E11475-
SECTION PLAT

Ft. from N. Line

990 Ft. from S. Line

Ft. from E. Line

990 Ft. from W. Line

Butler County

Location

Rig up

Drilling and Remarks:

Comp 2411

CE 2416

5' @ 2416

809 ft

Pump 47 oil + 25W

P.D. 38° E

RECORD

Cased _____ in., _____ ft.

Sand _____

Gas _____

Oil _____

Total Depth 2465

PRODUCTION

1st 24 hrs. Nat. _____

1st 24 hrs. after shot _____

Gas _____ Cu. Ft.

Dry Hole _____

Abandoned _____

Date

DEC 30 1947 19

S. J. LEWIS Scout