
Form 51—10M—8-19—CroMac

Map No. 4 Sec. 20 Twp. 23 R. 4

Well No. 4 X Ferrier Farm

Oklahoma C & R Company

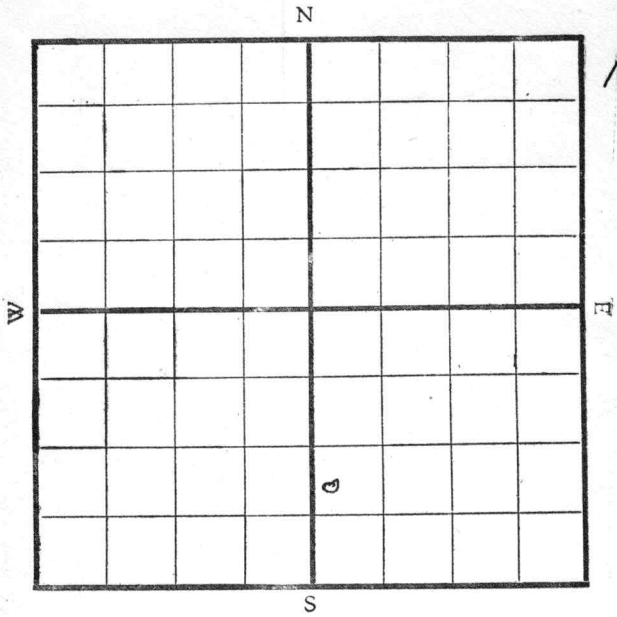

Location _____

Drilling Remarks:

Rig Up _____

Drilling Remarks:

COMPLETED

RECORD

Cased _____ in. _____ ft.

Sand _____

Gas _____

Oil _____

Total Depth _____

PRODUCTION

1st 24 hrs. Nat. _____

1st 24 hrs. after shot _____

Gas _____ cu. ft.

Dry Hole _____

Abandoned _____

Form 252A 2M-10-19 CroMac.

Map No. _____ Sec. 20 Twp. 23 R. 4

Well No. 64 Ferrier Farm

Oklahoma P & R. Company

_____ Contractor


SE Quarter

_____ Ft. from N. Line

760 Ft. from S. Line

_____ Ft. from E. Line

200 Ft. from W. Line

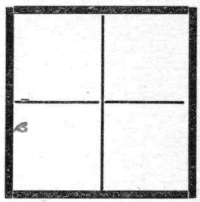

1917 Date	REPORT
11/18	Location Ground FIRST REPORT
25	Timbers on Ground.
12/2	Rig
9	Timbers on Ground.
16	T. O. G.
23	Rig up.
1/4/20	Rig up COMPLETED
6	Rig
14	Rig
19	Tools.
27	Tools
2/2	Spud
9	Fishing Casing 860'
16	" " "
23	Dlg 1720'
3/1	" 1930'
8	" 2135'
15	6 5/8 - 2385
29	2388' - 91' - 150 Sand

Form 26—1M—4-19—Mid-West


Map No. K14 Sec. 20 Twp. 23 R. 4

Well No. 6 Ferrier

Oklahoma P & R Company

Contractor

SECTION PLAT

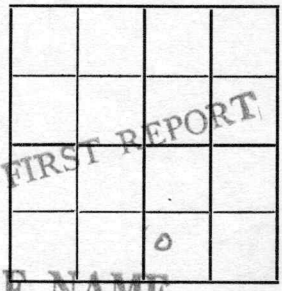

760 Ft. from N. Line

Ft. from S. Line

Ft. from E. Line

200 Ft. from W. Line

FIRST REPORT

CHANGE FEE NAME

Location

Rig up

Drilling and Remarks:

J. O. T.

RECORD

Cased in., ft.

Sand

Gas

Oil

Total Depth

PRODUCTION

1st 24 hrs. Nat.

1st 24 hrs. after shot

Gas Cu. Ft.

Dry Hole

Abandoned

Date

11/18/1919

Pyle Scout

Form 26—1M—4-19—Mid-West


Map No. K14 Sec. 20 Twp. 23 R. 4

Well No. 4 Fernier

Okla Gas & Co. Company

Contractor

SECTION PLAT

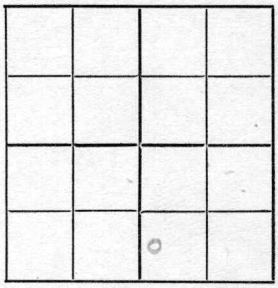

760 Ft. from N. Line

Ft. from S. Line

Ft. from E. Line

200 Ft. from W. Line

Location

Rig up

Drilling and Remarks:

Tools
Change
number

RECORD

Cased in., ft.

Sand

Gas

Oil

Total Depth

PRODUCTION

1st 24 hrs. Nat.

1st 24 hrs. after shot

Gas Cu. Ft.

Dry Hole

Abandoned

Date

1/20 191 20

Pyle Scout

Form 26—1M—4-19—Mid-West


Map No. K 14 Sec. 20 Twp. 23 R. 4

Well No. 4 Ferrier

Oklahoma O+R Company

Contractor

SECTION PLAT

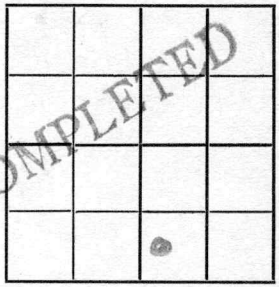

Ft. from N. Line

760 Ft. from S. Line

Ft. from E. Line

200 Ft. from W. Line

Location

Rig up

Drilling and Remarks:

RECORD

Cased in., ft.

Sand 2388-91

Gas

Oil

Total Depth

PRODUCTION

1st 24 hrs. Nat. 150 bbls

1st 24 hrs. after shot

Gas Cu. Ft.

Dry Hole

Abandoned

Date

3/29 1920

Pyle Scout