


Map No. _____ Sec. 8 Twp. 26 R. 5Well No. 6 Bateman Farm_____Empire Company

NORTH

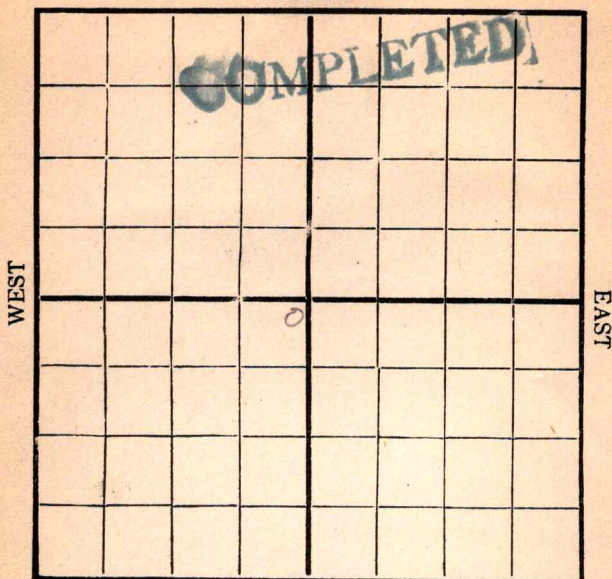

SOUTH

Location _____

Rig Up _____

Drilling Remarks:

Drilling Remarks:

RECORD

PRODUCTION

Cased _____ in _____ Ft.
 Sand _____
 Gas _____
 Oil _____
 Total Depth _____

1st 24 hrs. Nat. _____
 1st 24 hrs. after shot _____
 Gas _____ Cu. Ft.
 Dry Hole _____
 Abandoned _____

Map No. _____ Sec. 8 Twp. 26 R. 5
Well No. 6 Bathman Farm _____
Cumprine Company _____
NORTH

WEST

EAST

SOUTH

Location _____
Rig Up _____
Drilling and remarks _____

RECORD

Cased _____ in. _____ Ft.
Sand _____
Gas _____
Oil _____
Total Depth _____

PRODUCTION

1st 24 hrs. Nat. _____
1st 24 hrs. after shot _____
Gas _____ Cu. Ft.
Dry Hole _____
Abandoned _____

FIRST REPORT


Date 4/5, 1917 Cumprine Scout

Map No. K14 Sec. 8 Twp. 26 R. 5
 Well No. 6 Anderson Farm
Engine Company

NORTH

WEST

EAST

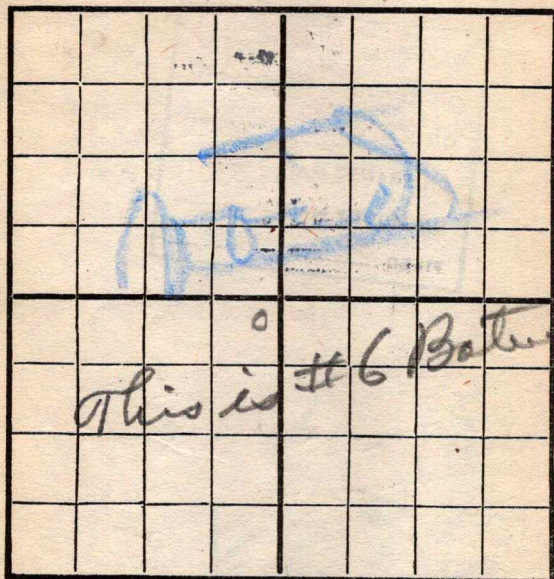

This is #6 Batten

SOUTH

Location _____
 Rig Up ☒ _____
 Drilling and remarks _____

RECORD

Cased _____ in. _____ Ft.
 Sand _____
 Gas _____
 Oil _____
 Total Depth _____

PRODUCTION

1st 24 hrs. Nat. _____
 1st 24 hrs. after shot _____
 Gas _____ Cu. Ft.
 Dry Hole _____
 Abandoned _____

Date 4/11, 1917 Cardiff Scout

Send in tickets
showing the east side
of recs 8-26-5
and watch it closer.
RdHK


RETURNED BY	_____
ON TRACING	_____
ON J. S. C. MAP	_____
ON FRANTZ MAP	_____
ON MOODY MAP	_____
FILED	_____

Map No. _____ Sec. 8 Twp. 26 R. 5
 Well No. 6 Bateman Farm _____
Engine Company _____

NORTH

WEST

EAST

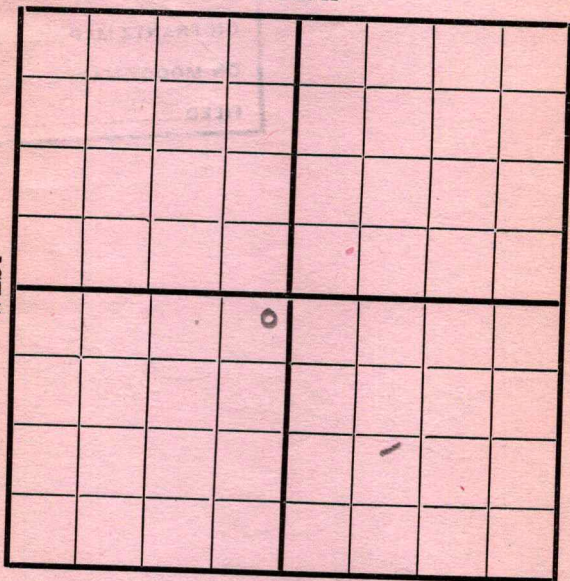

SOUTH

Location _____
 Rig Up ☒ _____
 Drilling and remarks _____

RECORD

Cased _____ in. _____ Ft.
 Sand _____
 Gas _____
 Oil _____
 Total Depth _____

PRODUCTION

1st 24 hrs. Nat. _____
 1st 24 hrs. after shot _____
 Gas _____ Cu. Ft.
 Dry Hole _____
 Abandoned _____

Date


4/11, 191 7 Candis Scout

Map No. _____ Sec. 8 Twp. 26 R. 5
 Well No. 6 B. B. B. Farm _____
Company Company _____

NORTH

WEST

EAST

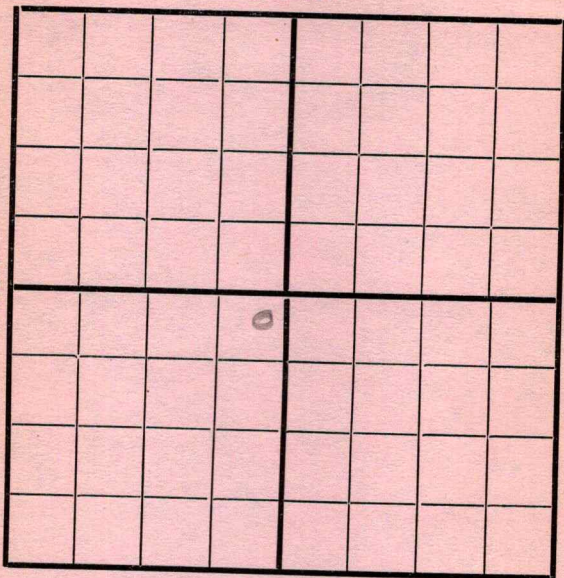

SOUTH

Location _____
 Rig Up _____
 Drilling and remarks _____

RECORD

Cased _____ in. _____ Ft.
 Sand _____
 Gas _____
 Oil _____
 Total Depth _____

PRODUCTION

1st 24 hrs. Nat. _____
 1st 24 hrs. after shot _____
 Gas _____ Cu. Ft.
 Dry Hole _____
 Abandoned _____


Date 4/19, 1912 Cardiff Scout

Map No. _____ Sec. 8 Twp. 26 R. 5
Well No. 6 Batterson Farm
Engine Company

NORTH

WEST

EAST

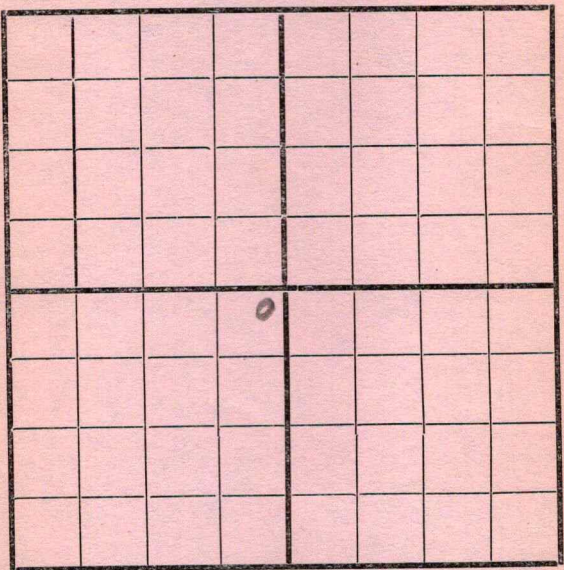

SOUTH

Location _____
Rig Up ☒ _____
Drilling and remarks _____

RECORD

Cased _____ in. _____ Ft.
Sand _____
Gas _____
Oil _____
Total Depth _____


PRODUCTION

1st 24 hrs. Nat. _____
1st 24 hrs. after shot _____
Gas _____ Cu. Ft.
Dry Hole _____
Abandoned _____

Date 4/26 191 7 Cordery Scout

Map No. _____ Sec. 8 Twp. 26 R. 5Well No. 6 Batman Farm __________Emp._____
Company

NORTH

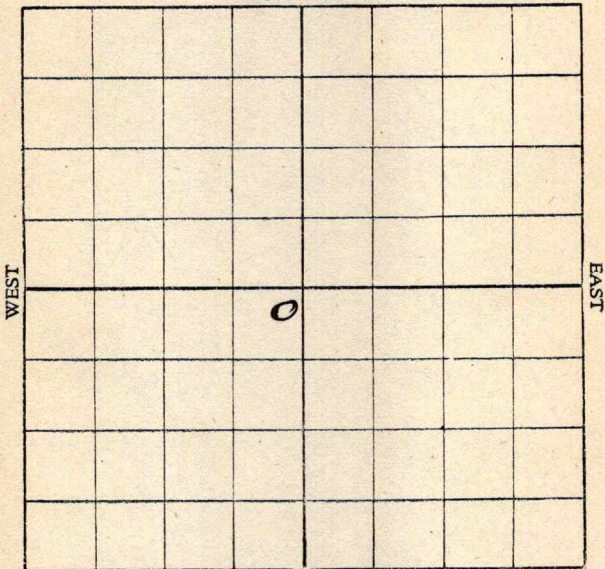

SOUTH

Location _____

Rig up _____

Drilling and remarks:

Rig

RECORD

Cased _____ in. _____ Ft.

Sand _____

Gas _____

Oil _____

Total Depth _____

PRODUCTION

1st 24 hrs. Nat. _____

1st 24 hrs. after shot _____

Gas _____ Cu. Ft.

Dry Hole _____

Abandoned _____

Date

6/5, 1917, Crocker Scout

Map No. _____ Sec. 8 Twp. 26 R. 5Well No. 6 Batman Farm _____
Emp. Company _____

NORTH

			0				

WEST

EAST

SOUTH

Location _____

Rig up _____

Drilling and remarks:

Rig.

RECORD

Cased _____ in. _____ Ft.

Sand _____

Gas _____

Oil _____

Total Depth _____

PRODUCTION

1st 24 hrs. Nat. _____

1st 24 hrs. after shot _____

Gas _____ Cu. Ft.


Dry Hole _____

Abandoned _____

Date

5/12, 1917 Crocker Scout

Map No. _____ Sec. 8 Twp 26 R. 5
Well No. 6 Batman Farm _____
Emp. Company _____
NORTH

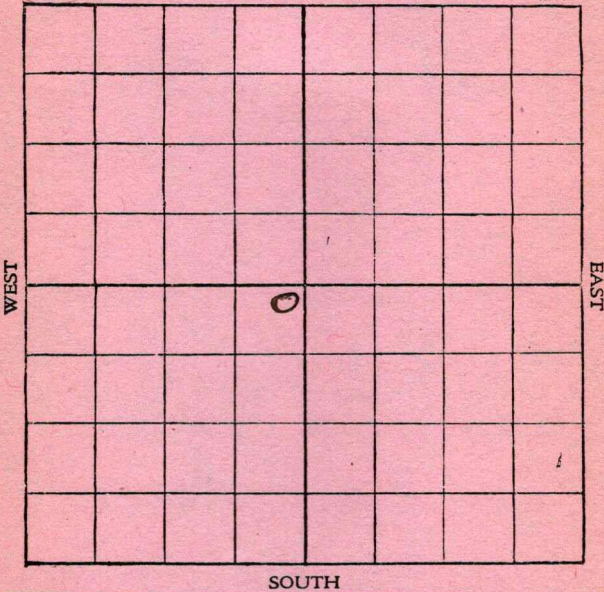

Location _____	RECORD
Rig up _____	Cased _____ in. _____ Ft.
Drilling and remarks:	Sand _____
<u>Rig</u>	Gas _____
	Oil _____
	Total Depth _____
	PRODUCTION
	1st 24 hrs. Nat. _____
	1st 24 hrs. after shot _____
	Gas _____ Cu. Ft.
	Dry Hole _____
	Abandoned _____

Date _____
5/19, 1917, Crocker Scout

Map No. _____ Sec. 8 Twp. 26 R. 5Well No. 6 Batman Farm __________Emp. Company _____

NORTH

			0				

WEST

EAST

SOUTH

Location _____

Rig up _____

Drilling and remarks:

Rig.

RECORD

Cased _____ in. _____ Ft.

Sand _____

Gas _____

Oil _____

Total Depth _____

PRODUCTION

1st 24 hrs. Nat. _____

1st 24 hrs. after shot _____

Gas _____ Cu. Ft.

Dry Hole _____

Abandoned _____


Date

7/26, 1917, Crocker Scout

Map No. _____ Sec. 8 Twp. 26 R. 5
 Well No. 6 Batman Farm _____
Emp Company _____

NORTH

WEST

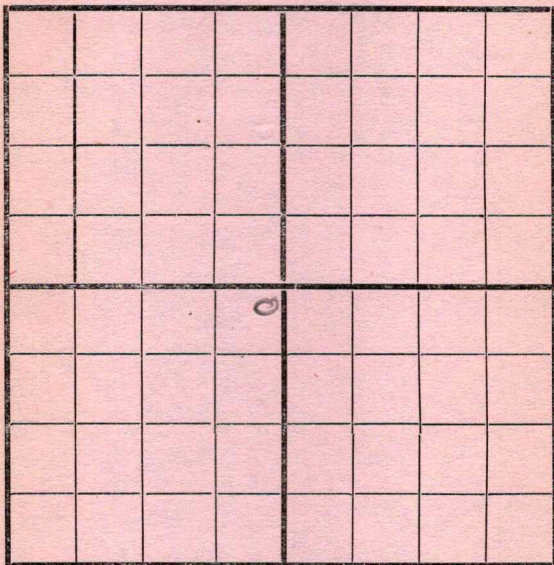

EAST

SOUTH

Location _____
 Rig Up _____
 Drilling and remarks _____

Spud

RECORD

Cased _____ in. _____ Ft.
 Sand _____
 Gas _____
 Oil _____
 Total Depth _____


PRODUCTION

1st 24 hrs. Nat. _____
 1st 24 hrs. after shot _____
 Gas _____ Cu. Ft.
 Dry Hole _____
 Abandoned _____

Date 6/2, 1917 Brocker Scout

Map No. _____ Sec. 8 Twp. 26 R. 5
 Well No. 6 Batman Farm _____
Emp Company _____

NORTH

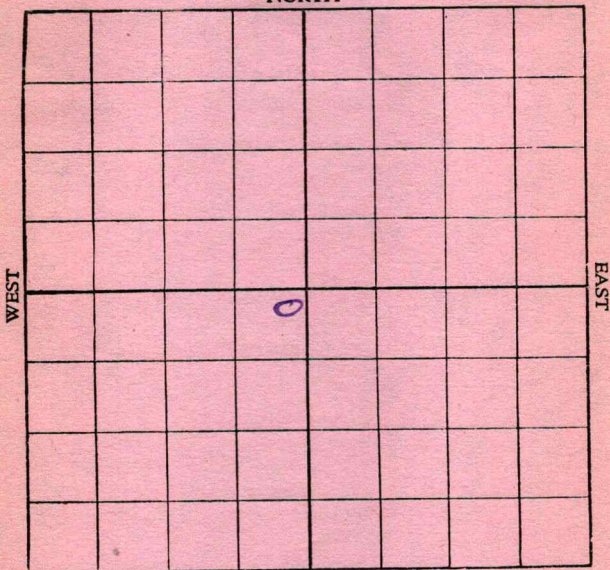

SOUTH

Location _____

Rig up _____

Drilling and remarks:

D-250'

RECORD

Cased _____ in. _____ Ft.

Sand _____

Gas _____

Oil _____

Total Depth _____

PRODUCTION

1st 24 hrs. Nat. _____

1st 24 hrs. after shot _____

Gas _____ Cu. Ft.

Dry Hole _____

Abandoned _____

Date

JUN 9 - 1917C. J. Crocker

, 191


Scout

Map No. _____ Sec. 8 Twp. 26 R. 5

Well No. 6 Batman Farm _____

_____ Emp. Company _____

NORTH

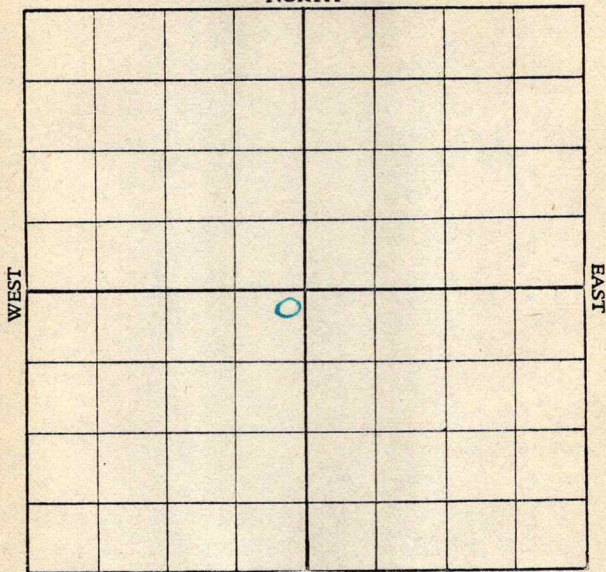

SOUTH

Location _____

Rig up _____

Drilling and remarks:

D-620'

RECORD

Cased _____ in. _____ Ft.

Sand _____

Gas _____

Oil _____

Total Depth _____

PRODUCTION

1st 24 hrs. Nat. _____

1st 24 hrs. after shot _____

Gas _____ Cu. Ft.

Dry Hole _____

Abandoned _____

Date

JUN 16 1917

, 191


G. J. Crocker Scout

Map No. _____ Sec. 8 Twp. 26 R. 5
Well No. 6 Bateman Farm
Empire Company

NORTH

WEST

EAST

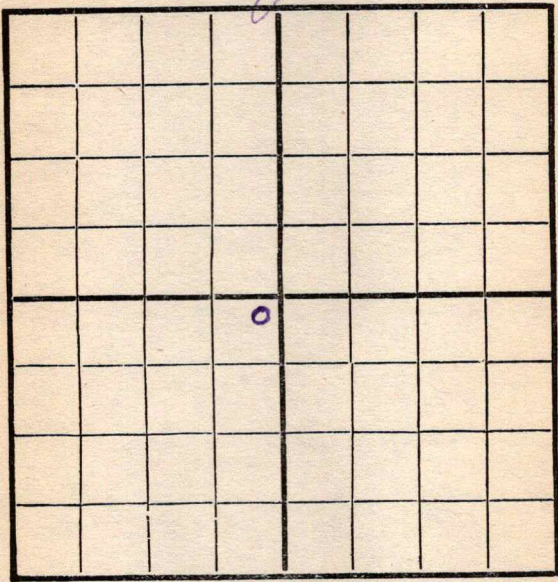

SOUTH

Location _____
Rig Up _____
Drilling and remarks _____

10-1325

RECORD

Cased _____ in. _____ Ft.
Sand _____
Gas _____
Oil _____
Total Depth _____

PRODUCTION

1st 24 hrs. Nat. _____
First 24 hrs. after shot _____
Gas _____ Cu. Ft.
Dry Hole _____
Abandoned _____

Date

JUN 22 1917


191

E. J. Crocker Scout

Map No. _____ Sec. 8 Twp. 26 R. 5Well No. 6 Bateman Farm _____

Company _____

NORTH

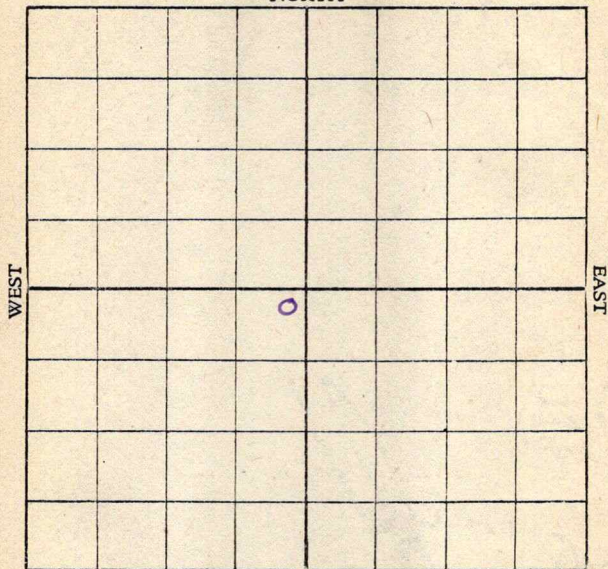

SOUTH

Location _____

Rig up _____

Drilling and remarks:

20-1690

RECORD

Cased _____ in. _____ Ft.

Sand _____

Gas _____

Oil _____

Total Depth _____

PRODUCTION

1st 24 hrs. Nat. _____

1st 24 hrs. after shot _____

Gas _____ Cu. Ft.

Dry Hole _____

Abandoned _____

Date JUN 30 1917

, 191

C. J. Crocker Scout

Map No. _____ Sec. 8 Twp. 26 R. 5

Well No. 4 Batman Farm
Emp Company

NORTH

WEST

EAST

SOUTH

Location _____

Rig up-----

Drilling and remarks:

D-2300'

2 bails of
water per

RECORD

Cased _____ in. _____ Ft.

Sand _____

Gas _____

Oil _____

Total Depth _____

PRODUCTION

1st 24 hrs. Nat.-----

1st 24 hrs. after shot_____

Gas _____ Cu. Ft. _____

Dry Hole

Abandoned _____

Date _____


JUL 7 1917

... , I

T. Crocker Scout

Map No. _____ Sec. 8 Twp. 26 R. 5Well No. 6 Bateman FarmEmp. Company

NORTH

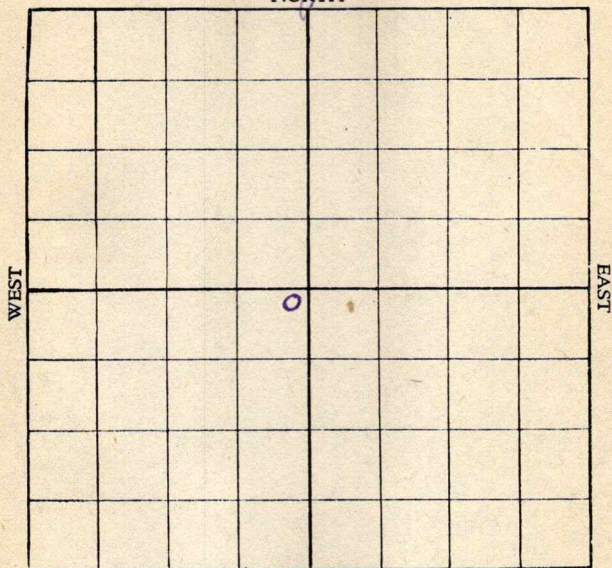

SOUTH

Location _____

Rig up _____

Drilling and remarks:

P.S. 24 24'
pulling pipe
show of oil

RECORD

Cased _____ in. _____ Ft.

Sand _____

Gas _____

Oil _____

Total Depth _____

PRODUCTION

1st 24 hrs. Nat. _____

1st 24 hrs. after shot _____

Gas _____ Cu. Ft.

Dry Hole _____

Abandoned _____

Date

JUL 14 1917

G. T. Crocker
 Scout

Map No. Sec. 8, Twp. 26, R. 5


Well No. 6 Balmora

..... Company

NORTH

WEST

EAST

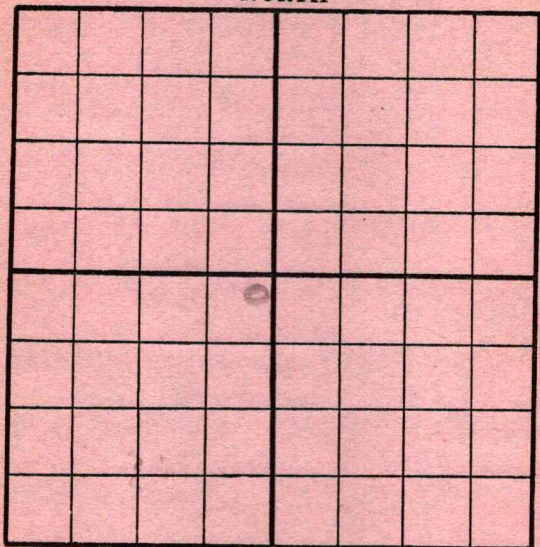

SOUTH

RECORD

Location

Cased.....in,Ft.

Rig up.....

Sand

Drilling and remarks:

Gas

Oil

Total Depth

PRODUCTION

1st 24 hrs. Nat.....

1st 24 hrs. after shot.....

Gas.....Cu. ft.

Dry Hole

Abandoned


Date

7/17 191 7 Andy Scout

Map No. _____ Sec. 8 Twp. 26 R. 5Well No. 6 Bateman Farm _____Empire Company _____

NORTH

WEST

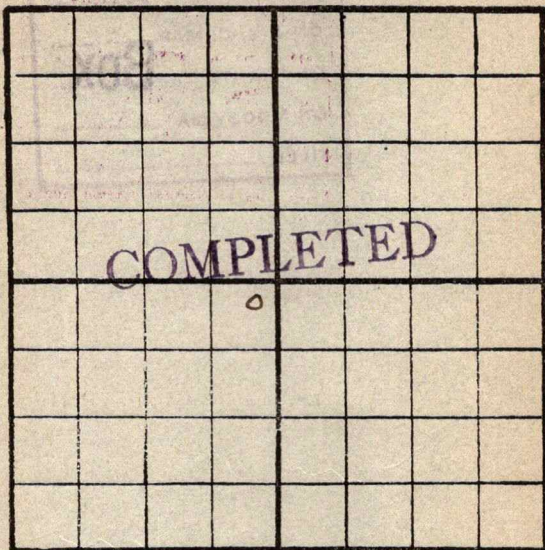

EAST

SOUTH

Location _____

Rig up _____

Drilling and remarks:

Est at 125Bhls

RECORD

Cased _____ in. _____ Ft.

Sand 2424-2474

Gas _____

Oil _____

Total Depth _____

PRODUCTION

1st. 24 hrs. Nat. _____

1st. 24 hrs. after shot _____

Gas _____ Cu. Ft.

Dry Hole _____

Abandoned _____

Date


7/27 1917 Condy Scout

Map No. _____ Sec. 8 Twp. 26 R. 5
 Well No. Batman Farm _____
Engine Company _____

NORTH

WEST

EAST

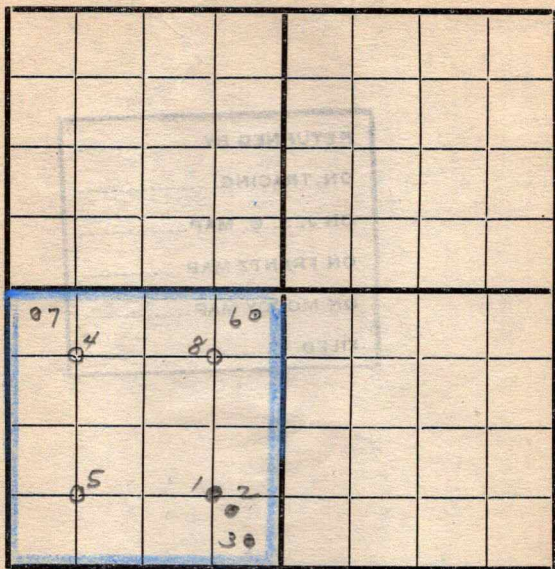

SOUTH

Location _____
 Rig Up _____
 Drilling and remarks _____

RECORD

Cased _____ in. _____ Ft.
 Sand _____
 Gas _____
 Oil _____
 Total Depth _____

PRODUCTION

1st 24 hrs. Nat. _____
 1st 24 hrs. after shot _____
 Gas _____ Cu. Ft.
 Dry Hole _____
 Abandoned _____

Date

191

Scout