


Map No. _____ Sec. 8 Twp. 26 R. 5Well No. 8 Batman Farm __________Empire_____
Company

NORTH

WEST

EAST

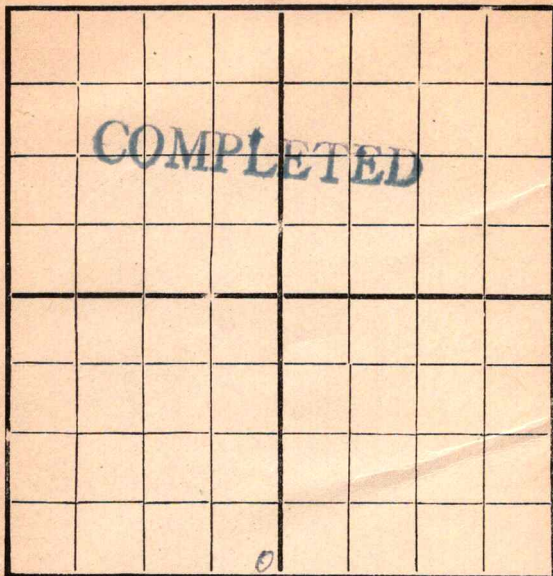

SOUTH

Location _____

Rig Up _____

Drilling Remarks:

Drilling Remarks:

RECORD

PRODUCTION

Cased _____ in _____ Ft.

1st 24 hrs. Nat. _____

Sand _____

1st 24 hrs. after shot _____

Gas _____

Gas _____ Cu. Ft.

Oil _____


Dry Hole _____

Total Depth _____

Abandoned _____

Map No. K-14 Sec. 8 Twp. 26 R. 5Well No. 8 Batman FarmEmp. Company

NORTH

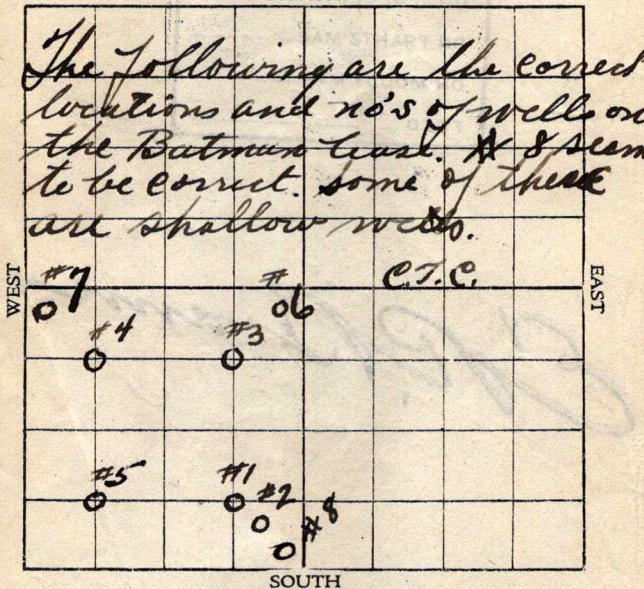

Location _____

Rig up _____

Drilling and remarks:

Rig.

RECORD

Cased _____ in. _____ Ft.

Sand _____

Gas _____

Oil _____

Total Depth _____

PRODUCTION

1st 24 hrs. Nat. _____

1st 24 hrs. after shot _____

Gas _____ Cu. Ft.

Dry Hole _____

Abandoned _____

Date

5/5, 1917 Crocker Scout


RETURNED BY RUP
 ON TRACING 240
 ON J. S. C. MAP _____
 ON FRANTZ MAP _____
 ON MOODY MAP _____
 FILED _____

RUP.

C. R. Bram

This sum of
 money must be
 used for
 other tickets
 as #3
 that
 RUP.

Map No. _____ Sec. 8 Twp. 26 R. 5
 Well No. 8 Batman Farm _____
E. m. p. Company _____
 NORTH

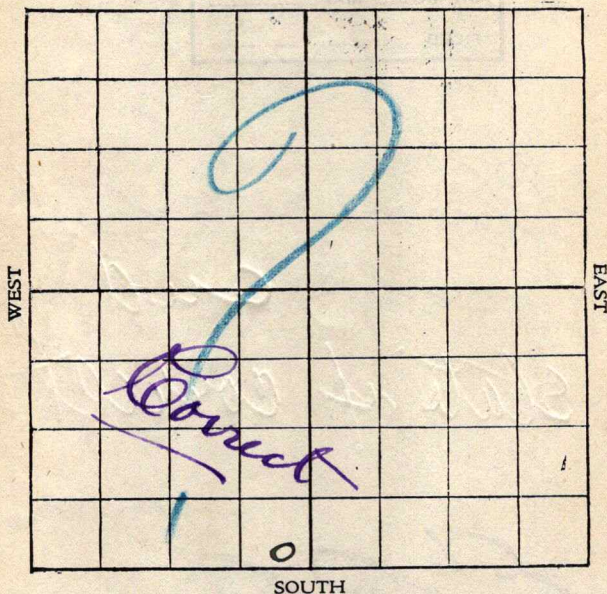

SOUTH

Location _____

Rig up _____

Drilling and remarks:

Rig.

RECORD

Cased _____ in. _____ Ft.

Sand _____

Gas _____

Oil _____

Total Depth _____

PRODUCTION

1st 24 hrs. Nat. _____

1st 24 hrs. after shot _____

Gas _____ Cu. Ft.

Dry Hole _____

Abandoned _____

Date

7/12, 1917, Crocker Scout

RETURNED BY W. S. M.

ON TRACING W. S. M.

ON J. S. C. MAP W. S. M.

ON FRANTZ MAP W. S. M.


ON MOODY MAP W. S. M.

FILED W. S. M.

Please check
location and
state of correct

E. P. Bram

Map No. _____ Sec. 8 Twp 26 R. 5
 Well No. 8 Batman Farm _____
Emp. Company _____
 NORTH

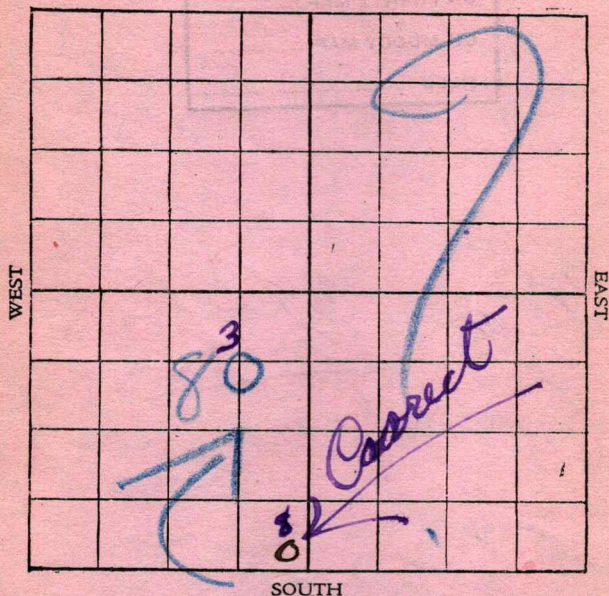

Location _____

Rig up _____

Drilling and remarks:

Rig

RECORD

Cased _____ in. _____ Ft.

Sand _____

Gas _____

Oil _____

Total Depth _____

PRODUCTION

1st 24 hrs. Nat. _____

1st 24 hrs. after shot _____

Gas _____ Cu. Ft.

Dry Hole _____

Abandoned _____

Date

5/19, 1917, Procter Scout

RETURNED BY Wm
ON TRACING Wm
ON J. S. C. MAP _____
ON FRANTZ MAP _____
ON MOODY MAP _____
FILED _____

Please Check
Location

E. P. Brann


Map No. _____ Sec. 8 Twp. 26 R. 5

Well No. 8 Batman Farm _____
Emp Company

NORTH

WEST

EAST

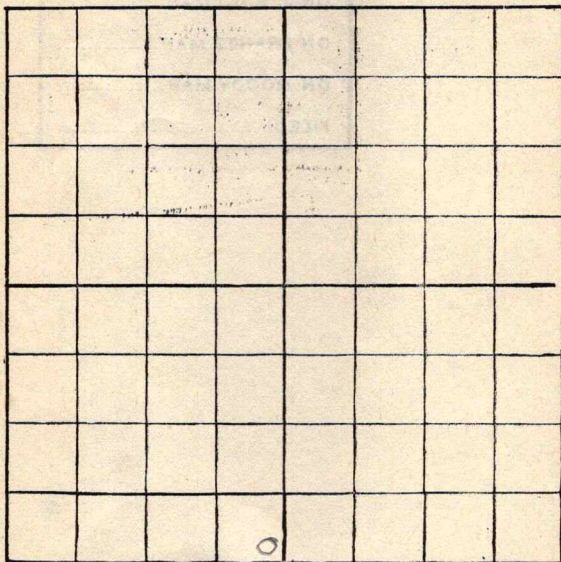

SOUTH

Location _____

Rig up _____

Drilling and remarks:

Rig.

RECORD

Cased _____ in. _____ Ft.

Sand _____

Gas _____

Oil _____

Total Depth _____

PRODUCTION

1st 24 hrs. Nat. _____

1st 24 hrs. after shot _____

Gas _____ Cu. Ft.

Dry Hole _____

Abandoned _____

Date

7/26, 1917, C. Crutcher Scout

Map No. _____ Sec. 8 Twp. 26 R 5
 Well No. 8 Batman Farm _____
Emps Company _____

NORTH

WEST

EAST

SOUTH

Location _____
 Rig Up _____
 Drilling and remarks

*Tools on
Ground*

RECORD

Cased _____ in. _____ Ft.
 Sand _____
 Gas _____
 Oil _____
 Total Depth _____

PRODUCTION

1st 24 hrs. Nat. _____
 1st 24 hrs. after shot _____
 Gas _____ Cu. Ft.
 Dry Hole _____
 Abandoned _____

Date

6/12, 1917 Erzher Scout

Map No. _____ Sec. 8 Twp. 26 R. 5
 Well No. 8 Batman Farm _____
 _____ Emp. Company _____

NORTH

WEST

EAST

SOUTH

Location _____

Rig up _____

Drilling and remarks:

*Moving
in Tool.*

RECORD

Cased _____ in. _____ Ft.

Sand _____

Gas _____

Oil _____

Total Depth _____

PRODUCTION

1st 24 hrs. Nat. _____

1st 24 hrs. after shot _____

Gas _____ Cu. Ft.

Dry Hole _____

Abandoned _____

Date


11/19 1917 B. T. ... Scout

Map No. _____ Sec. 8 Twp. 26 R. 5Well No. S Butman Farm __________ Emp Company _____

NORTH

WEST

EAST

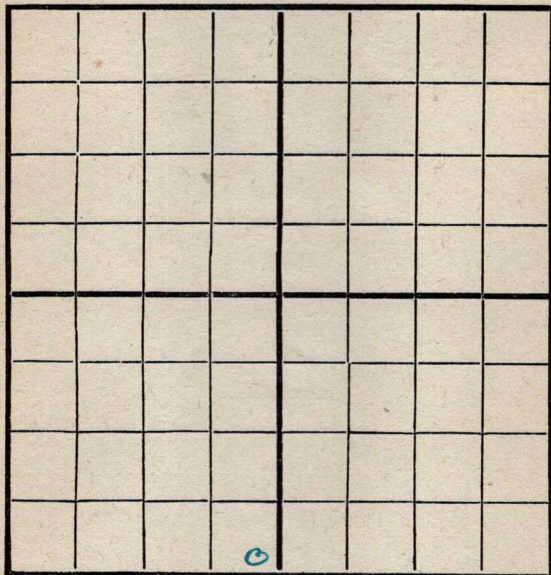

SOUTH

Location _____

Rig Up _____

Drilling and remarks

Spud

RECORD

Cased _____ in. _____ Ft.

Sand _____

Gas _____

Oil _____

Total Depth _____

PRODUCTION

1st 24 hrs. Nat. _____

1st 24 hrs. after shot _____

Gas _____ Cu. Ft.

Dry Hole _____

Abandoned _____


Date

JUN 16 1917

191

G. J. Crocker Scout

Map No. _____ Sec. 8 Twp. 26 R. 5
 Well No. 8 2 Baturan Farm
 _____ Empire Company
 NORTH

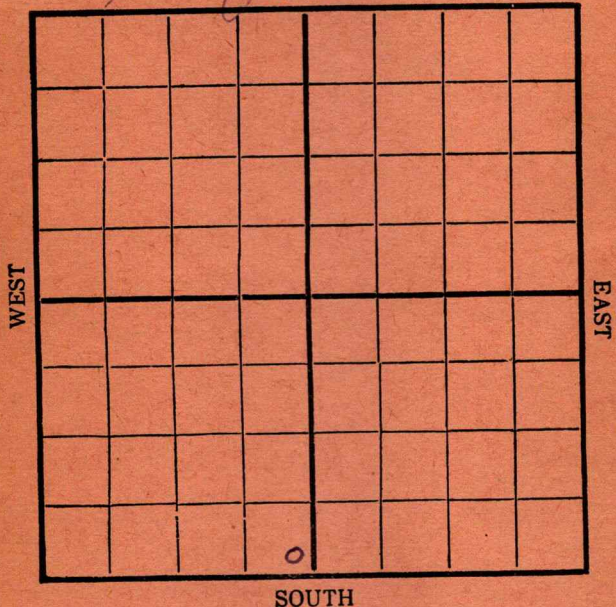

Location _____
 Rig Up _____
 Drilling and remarks

2-575

RECORD

Cased _____ in. _____ Ft.
 Sand _____
 Gas _____
 Oil _____
 Total Depth _____

PRODUCTION

1st 24 hrs. Nat. _____
 First 24 hrs. after shot _____
 Gas _____ Cu. Ft.
 Dry Hole _____
 Abandoned _____


Date

JUN 22 1917
 _____, 191

L. J. Crocker
 _____ Scout

Map No. _____ Sec. 8 Twp. 26 R. 5Well No. 8 2 Bateman FarmEmpire Company

NORTH

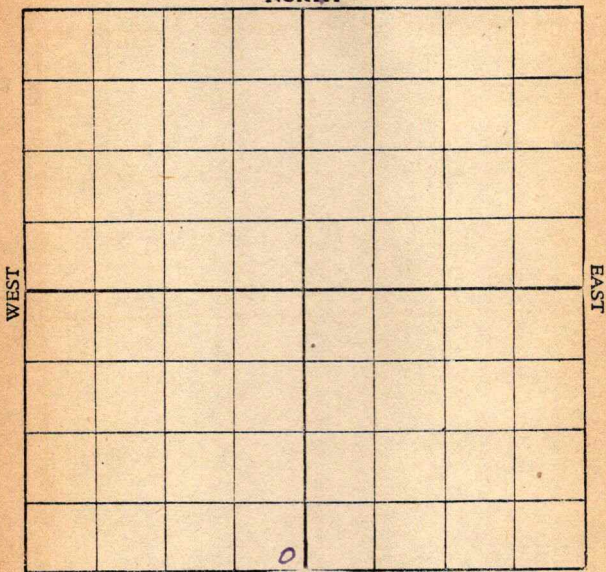

SOUTH

Location _____

Rig up _____

Drilling and remarks:

D-1410'

RECORD

Cased _____ in. _____ Ft.

Sand _____

Gas _____

Oil _____

Total Depth _____

PRODUCTION

1st 24 hrs. Nat. _____

1st 24 hrs. after shot _____

Gas _____ Cu. Ft.

Dry Hole _____

Abandoned _____

Date JUN 30 1917_____, 191____, C. T. Crocker Scout

Map No. _____ Sec. 8 Twp. 26 R. 5
 Well No. 8 Butman Farm _____
 _____ Emp. Company

NORTH

WEST

EAST

SOUTH

Location _____
 Rig up _____
 Drilling and remarks:

Mudding
7/7 gas. 1510

RECORD

Cased _____ in. _____ Ft.
 Sand _____
 Gas _____
 Oil _____
 Total Depth _____

PRODUCTION


1st 24 hrs. Nat. _____
 1st 24 hrs. after shot _____
 Gas _____ Cu. Ft.
 Dry Hole _____
 Abandoned _____

Date

JUL 7 1917, 191, T. Crocker Scout

Map No. _____ Sec. 8 Twp. 26 R. 5Well No. 8 Bateman Farm_____
Empire Company

NORTH

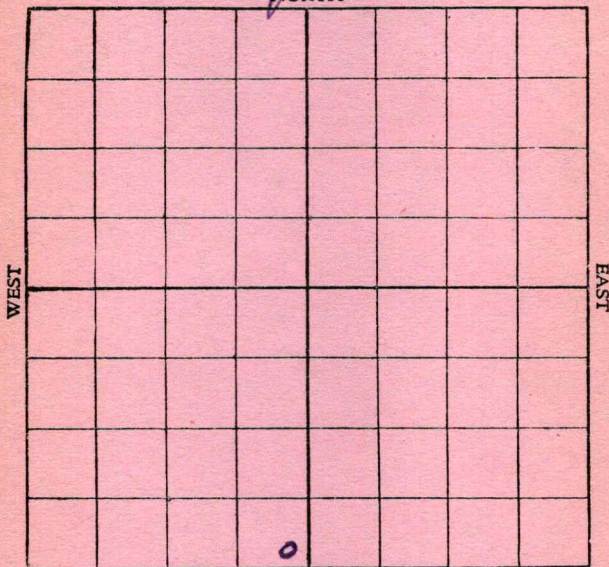

SOUTH

Location _____

Rig up _____

Drilling and remarks:

SP-1770 for water

RECORD

Cased _____ in. _____ Ft.

Sand _____

Gas _____

Oil _____

Total Depth _____

PRODUCTION

1st 24 hrs. Nat. _____

1st 24 hrs. after shot _____

Gas _____ Cu. Ft.

Dry Hole _____

Abandoned _____

Date


JUL 14 1917, 191

C. J. Crocker Scout

Map No. _____ Sec. 8 Twp. 26 R. 5Well No. 8 Bateman Farm
Empire Company

NORTH

WEST

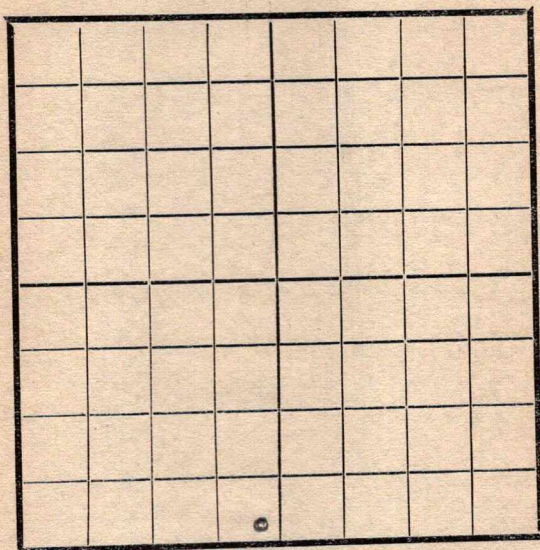

EAST

SOUTH

Location _____

Rig Up _____

Drilling and remarks

Tapped
2482

Cleaning
out

RECORD

Cased _____ in. _____ Ft.

Sand _____

Gas _____

Oil _____

Total Depth _____

PRODUCTION

1st 24 hrs. Nat. _____

1st 24 hrs. after shot _____

Gas _____ Cu. Ft.

Dry Hole _____

Abandoned _____


Date

8/9, 191*7* *Carley* Scout

Map No. _____ Sec. 8 Twp. 26 R. 5Well No. 8 Bottom Farm _____
Carpine Company

NORTH

WEST

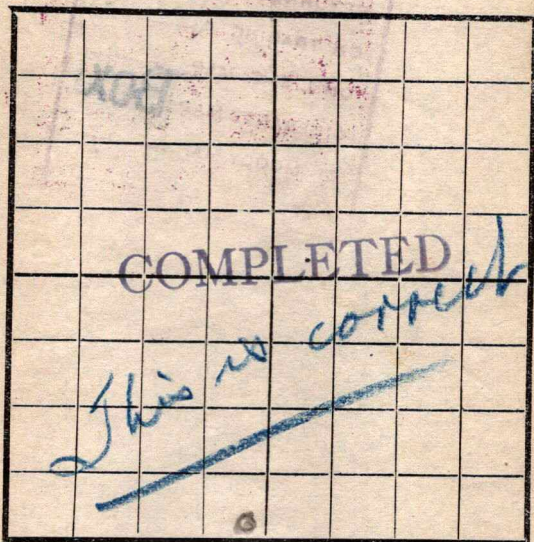

EAST

SOUTH

Location _____

Rig Up _____

Drilling and remarks

Est at500Barrels

RECORD

Cased _____ in. _____ Ft.

Sand 2440-2482

Gas _____

Oil _____

Total Depth _____

PRODUCTION

1st 24 hrs. Nat. _____

1st 24 hrs. after shot _____

Gas _____ Cu. Ft.


Dry Hole _____

Abandoned _____

Date

8/17, 1917 C. Conley Scout

Map No. _____ Sec. 8 Twp. 26 R. 5
 Well No. Batman Farm _____
Engine Company _____
 NORTH

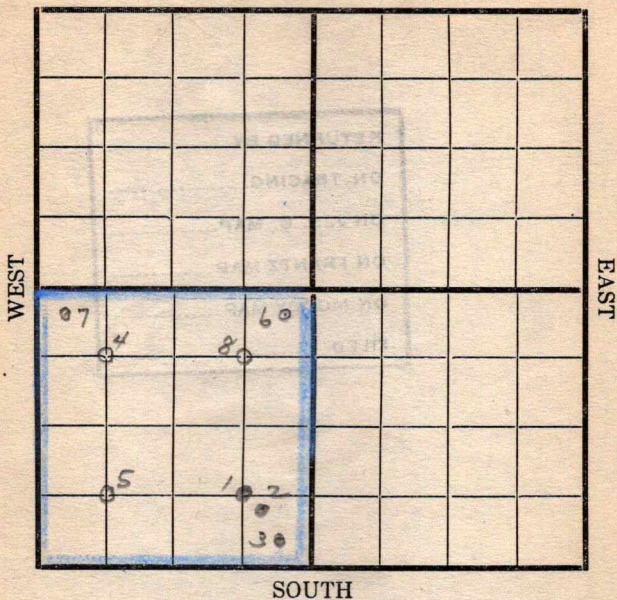

Location _____
 Rig Up _____
 Drilling and remarks _____

RECORD

Cased _____ in. _____ Ft.
 Sand _____
 Gas _____
 Oil _____
 Total Depth _____

PRODUCTION

1st 24 hrs. Nat. _____
 1st 24 hrs. after shot _____
 Gas _____ Cu. Ft.
 Dry Hole _____
 Abandoned _____

Date _____

_____, 191____, Scout _____