


Section 20 Township 23 Range 4-E

Well No. #1 Kehr

Company Phillips
Branine & Goering

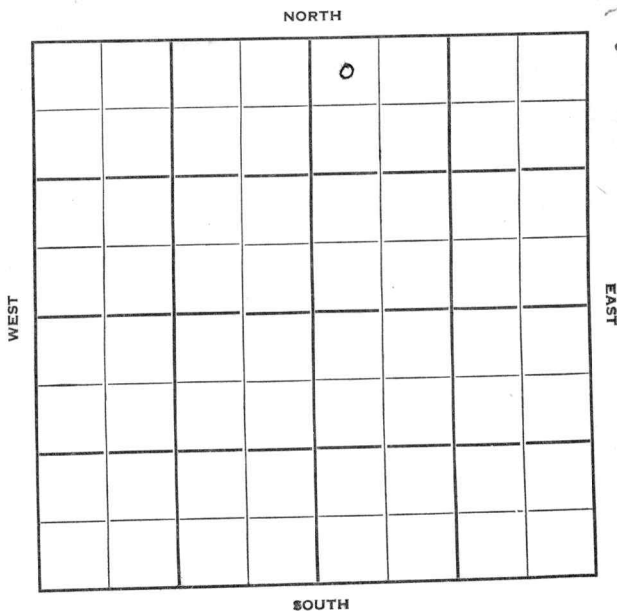

Butler

KANSAS

Sec. 20 Twp. 23 R. 4E ✓

Well No. #1 Kehr Farm

Branine & Goering Company

B & R Drlg. Contractor


330' **ABANDONED** Ft. from N. Line

_____ Ft. from S. Line

_____ Ft. from E. Line

330' Ft. from W. Line

NW NW NE

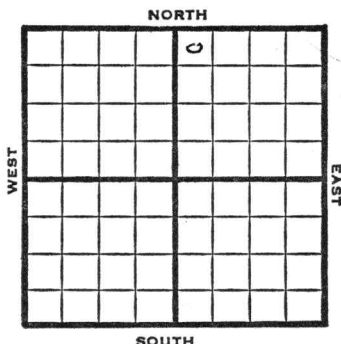

1950	Elev 1362	REPORT
6/28	Drlg.	
7/26	8 5/8" @ 84 Lans 1753 Hunton 2374 Viola 2459 Arb 2542-55 5 1/2" @ 2555 TD 2555 4/2376-77 S/6 bo 12 bwph 3/2414-15 3/2404-08 Comp 25 bopd 100 bw Completed	KC 1961 Maq sh 2437 Simp 2487
1951	COMPLETED	ABANDONED
1/31	Arb. 2542' 5" @ 2555' OTD 2555 to DD	
3/28	SWD Well TD 3121 Arb. 2542' 5" @ 2555' OTD 2555 Regan 3070' TD 3121 5000 A Comp. for SWD well Input 1440 bwpd ABANDONED	

Kansas

Map No. _____ Sec. 20 Twp. 23 R. 4EWell No. 1 Kehr_____ Branine & Goering _____ Company_____ B & R Drlg. _____ Contractor

NW NW NE

SECTION PLAT

330 Ft. from N. Line

_____ Ft. from S. Line

_____ Ft. from E. Line

330 Ft. from W. Line

Butler County

Location _____

Rig up _____

Drilling and Remarks:

drlg.

RECORD

Cased _____ in., _____ ft.

Sand _____

Gas _____

Oil _____

Total Depth _____

PRODUCTION

1st 24 hrs. Nat. _____

1st 24 hrs. after shot _____

Gas _____ Cu. Ft.

Dry Hole _____

Abandoned _____

Date

J. E. TYRA

JUN 28 1950 19

Scout

Kansas

Map No. _____ Sec. 20 Twp. 23 R. 4EWell No. 1 KehrBranine & Goering Company


Contractor

NW NW NE

E1. 1362
SECTION PLAT330 Ft. from N. Line

_____ Ft. from S. Line

_____ Ft. from E. Line

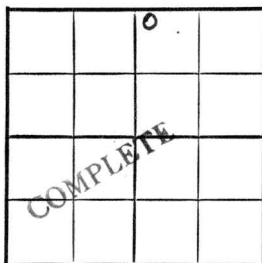330 Ft. from W. LineButler County

Location _____

Rig up _____

Drilling and Remarks:

8 5/8" @ 84

Lans. 1753

KC 1961

Hunton 2374

Maq. sh. 2437

Viola 2459

Simp. 2487

RECORD

Cased _____ in., _____ ft.

Sand _____

Gas _____

Oil _____

Total Depth 2555

PRODUCTION

1st 24 hrs. Nat. _____

1st 24 hrs. after shot _____

Gas _____ Cu. Ft.

Dry Hole _____

Abandoned _____

Date

JUL 26 1950

19

J. E. TYRA

Scout

Arb. 2542-55

5½" @ 2555

TD 2555

4/ 2376-77

S/ 6012 bwd

3/ 2414-15

3/ 2407-08

Comp. 25 bopd

100 bw

Scout Cards
Land Small Map
Land Wall Map
Tracings
France Map
Pledge Map
Misc.

County **Butler** State **Kansas**
 Sec. **20** (Blk. Twp.) **23** (Sur. Rge.) **4E** Map No.
 Operator **Phillips (was Branine & Goering)**
 Well No. **1** Farm **Kehr**
 Elev. **1364** Location **NW NW NE**

				0			

FIRST REPORT

330 Ft. From **N** Line **NE**
 330 Ft. From **W** Line **Quarter**

1st. Report **JAN 31 1951**

Completion

Remarks

OWDD
O.W.D.D

Spudding Date

Drlg. Data

Arb. 2542 5" @ 2555 OTD 2555 to DD

J. E. TYRA

County Butler State KansasSec. 20 (^{Blk.}_{Twp.}) 23 (^{Sur.}_{Rge.}) 4E Map No. _____Operator PhillipsWell No. 1 Farm KehrElev. 1364 Location NW NW NE

ABANDONED

COMPLETE

330 Ft. From N Line NE330 Ft. From W Line Quarter

1st. Report _____

Completion MAR 28 1951

Remarks _____

Spudding Date _____

Drilg. Data SWD well TD 3121Arb. 2542 5" @ 2555 OTD 2555Regan 3070 TD 3121 5000 AComp. for SWD well Input 1440 bwpd