

Map No. N-14 Sec. 8 Twp. 26 R. 5  
 Well No. 12 Anderson Farm  
Empire G. & F. Company

NORTH

|  |  |  |  |  |  |  |  |
|--|--|--|--|--|--|--|--|
|  |  |  |  |  |  |  |  |
|  |  |  |  |  |  |  |  |
SOUTH

WEST

EAST

Location -----

Rig Up -----

Drilling Remarks:

Drilling Remarks:

-----

-----

RECORD

PRODUCTION

Cased ----- in. ----- ft.

1st 24 hrs. Nat. -----

Sand -----

1st 24 hrs. after shot -----

Gas -----

Gas ----- cu. ft.

Oil -----

Dry Hole -----


Total Depth -----

Abandoned -----

**Empire** Company  
 Contractor

NORTH

WEST

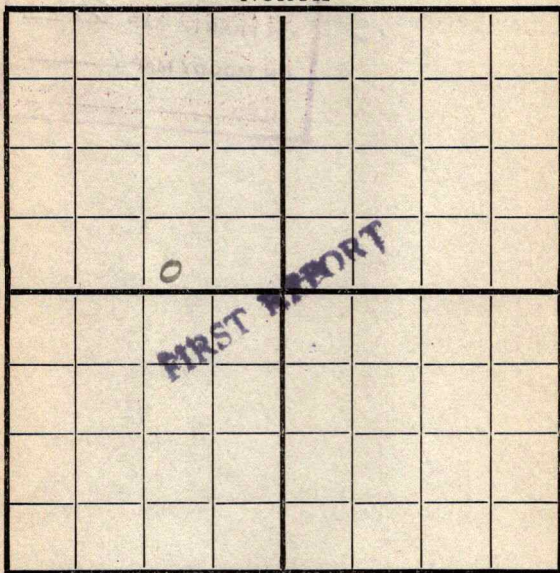

EAST

SOUTH

✓  
 Location \_\_\_\_\_

Rig up \_\_\_\_\_

Drilling and Remarks:

990' W  
 250' N

**RECORD**

Cased \_\_\_\_\_ in., \_\_\_\_\_ ft.

Sand \_\_\_\_\_

Gas \_\_\_\_\_

Oil \_\_\_\_\_

Total Depth \_\_\_\_\_

**PRODUCTION**

1st 24 hrs. Nat. \_\_\_\_\_

1st 24 hrs. after shot \_\_\_\_\_

Gas \_\_\_\_\_ Cu. Ft.

Dry Hole \_\_\_\_\_

Abandoned \_\_\_\_\_

Date

7/24 1918 **Cyle** Scout

Map No. \_\_\_\_\_ Sec. 8 Twp. 26 R. 5Well No. 12 AnderssonEmpire Company

Contractor \_\_\_\_\_

NORTH

WEST

EAST

SOUTH

Location ☒ \_\_\_\_\_

Rig up \_\_\_\_\_

Drilling and Remarks:

990 EL256 A

## RECORD

Cased \_\_\_\_\_ in., \_\_\_\_\_ ft.

Sand \_\_\_\_\_

Gas \_\_\_\_\_

Oil \_\_\_\_\_

Total Depth \_\_\_\_\_

## PRODUCTION

1st 24 hrs. Nat. \_\_\_\_\_

1st 24 hrs. after shot \_\_\_\_\_

Gas \_\_\_\_\_ Cu. Ft.

Dry Hole \_\_\_\_\_

Abandoned \_\_\_\_\_

Date

7/311918Dyke


Scout

Map No. \_\_\_\_\_ Sec. 8 Twp. 26 R. 5Well No. 12 Anderson\_\_\_\_\_  
Empire Company\_\_\_\_\_  
Contractor

NORTH

WEST

EAST

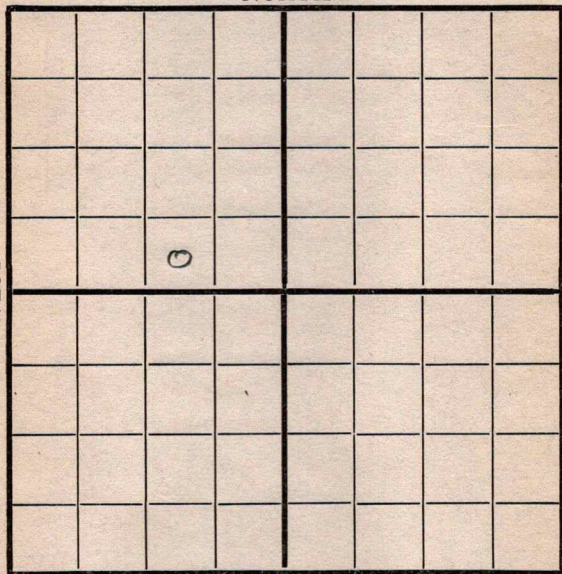

SOUTH

Location 990 E  
250 S

Rig up \_\_\_\_\_

Drilling and Remarks:

## RECORD

Cased \_\_\_\_\_ in., \_\_\_\_\_ ft.

Sand \_\_\_\_\_

Gas \_\_\_\_\_

Oil \_\_\_\_\_

Total Depth \_\_\_\_\_

## PRODUCTION

1st 24 hrs. Nat. \_\_\_\_\_

1st 24 hrs. after shot \_\_\_\_\_

Gas \_\_\_\_\_ Cu. Ft.

Dry Hole \_\_\_\_\_

Abandoned \_\_\_\_\_


Date

8  
7  
1918Gyle  
Scout

Map No. \_\_\_\_\_ Sec. 8 Twp. 26 R. 5  
 Well No. 12 Andersson  
Empire Company \_\_\_\_\_  
 Contractor \_\_\_\_\_

NORTH

WEST

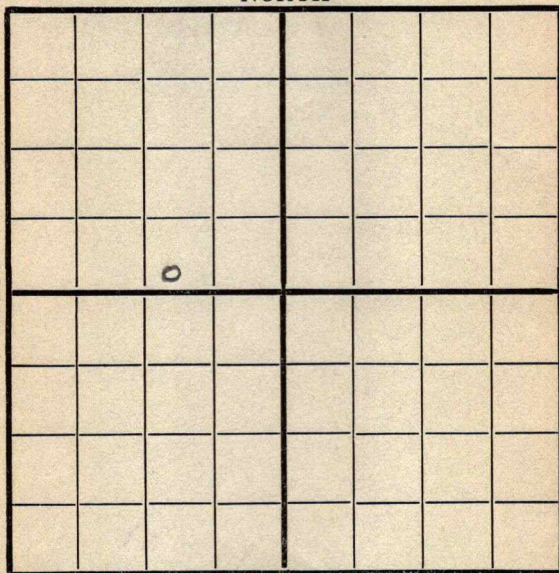

EAST

SOUTH

Location ☒

Rig up \_\_\_\_\_

Drilling and Remarks:

## RECORD

Cased \_\_\_\_\_ in., \_\_\_\_\_ ft.

Sand \_\_\_\_\_

Gas \_\_\_\_\_

Oil \_\_\_\_\_

Total Depth \_\_\_\_\_

## PRODUCTION

1st 24 hrs. Nat. \_\_\_\_\_

1st 24 hrs. after shot \_\_\_\_\_

Gas \_\_\_\_\_ Cu. Ft.

Dry Hole \_\_\_\_\_

Abandoned \_\_\_\_\_

Date

191


Scout

Map No. \_\_\_\_\_ Sec. 8 Twp. 26 R. 5  
 Well No. 12 Andersson  
Empire \_\_\_\_\_ Company \_\_\_\_\_  
 \_\_\_\_\_ Contractor \_\_\_\_\_

NORTH

WEST

EAST

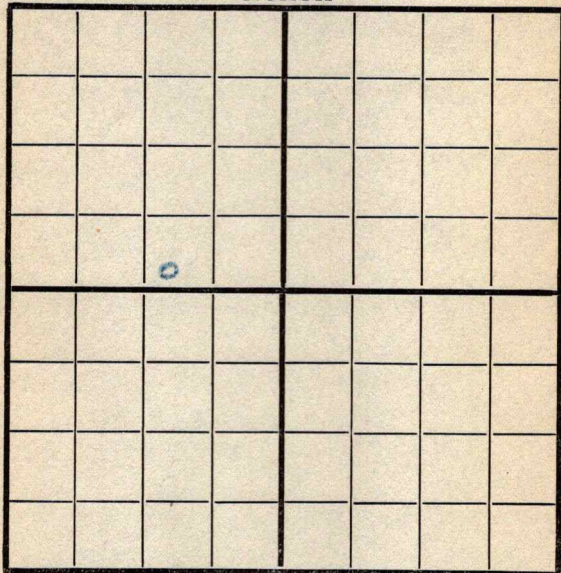

SOUTH

250' Δ - 990' ΔLocation ✓

Rig up \_\_\_\_\_

Drilling and Remarks:

## RECORD

Cased \_\_\_\_\_ in., \_\_\_\_\_ f

Sand \_\_\_\_\_

Gas \_\_\_\_\_

Oil \_\_\_\_\_

Total Depth \_\_\_\_\_

## PRODUCTION

1st 24 hrs. Nat. \_\_\_\_\_

1st 24 hrs. after shot \_\_\_\_\_

Gas \_\_\_\_\_ Cu. Ft.

Dry Hole \_\_\_\_\_

Abandoned \_\_\_\_\_

Date

1918

Pyle


Scout

Map No. K14 Sec. 8 Twp. 26<sup>S</sup> R. 5<sup>E</sup>  
 Well No. 12 Anderson  
Empire Company  
 Contractor

NORTH

WEST

EAST

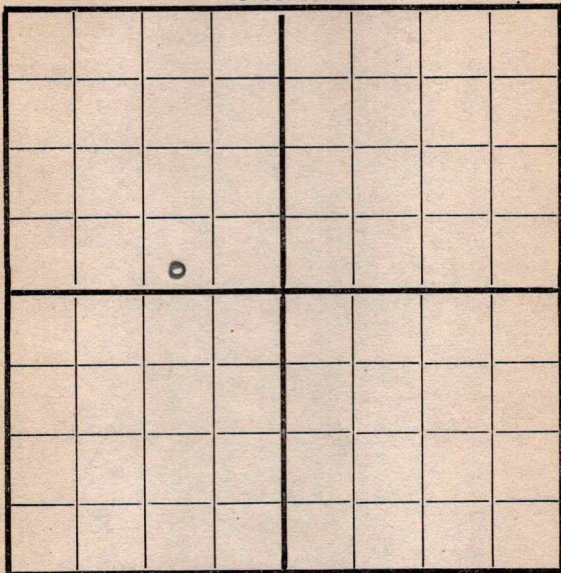

~~990 W~~ ~~250 N~~ SOUTH

Location \_\_\_\_\_

Rig up \_\_\_\_\_

Drilling and Remarks:

**RECORD**

Cased \_\_\_\_\_ in., \_\_\_\_\_ ft.

Sand \_\_\_\_\_

Gas \_\_\_\_\_

Oil \_\_\_\_\_

Total Depth \_\_\_\_\_

**PRODUCTION**

1st 24 hrs. Nat. \_\_\_\_\_

1st 24 hrs. after shot \_\_\_\_\_

Gas \_\_\_\_\_ Cu. Ft.

Dry Hole \_\_\_\_\_

Abandoned \_\_\_\_\_

Date

**Pyle**

191 8

Scout

Map No. K14 Sec. 8 Twp. 26<sup>S</sup> 5<sup>E</sup>  
 Well No. 12 Anderson  
Empire Company  
 Contractor

NORTH

WEST

EAST

SOUTH

Location ✓

Rig up

Drilling and Remarks:

990 from E  
 250 " D.

## RECORD

Cased.....in., .....ft.

Sand.....

Gas.....

Oil.....

Total Depth.....

## PRODUCTION

1st 24 hrs. Nat. ....

1st 24 hrs. after shot.....

Gas.....Cu. Ft.

Dry Hole.....

Abandoned.....

Date

9/5 1918

Pyle

Scout

Map No. K14 Sec. 8 Twp. 26<sup>S</sup> R. 5<sup>E</sup>Well No. 12 AndersonEmpire Company

Contractor

NORTH

WEST

EAST

SOUTH

✓ Location 990 ft  
250 ft

Rig up

Drilling and Remarks:

## RECORD

Cased \_\_\_\_\_ in., \_\_\_\_\_ ft.

Sand \_\_\_\_\_

Gas \_\_\_\_\_

Oil \_\_\_\_\_

Total Depth \_\_\_\_\_

## PRODUCTION

1st 24 hrs. Nat. \_\_\_\_\_

1st 24 hrs. after shot \_\_\_\_\_

Gas \_\_\_\_\_ Cu. Ft.

Dry Hole \_\_\_\_\_

Abandoned \_\_\_\_\_

Date

9/11

191


8

Pyle

Scout

Map No. X14 Sec. 8 Twp. 26<sup>S</sup> R. 5<sup>E</sup>  
 Well No. 12 Anderson  
Empire Company  
 Contractor

NORTH

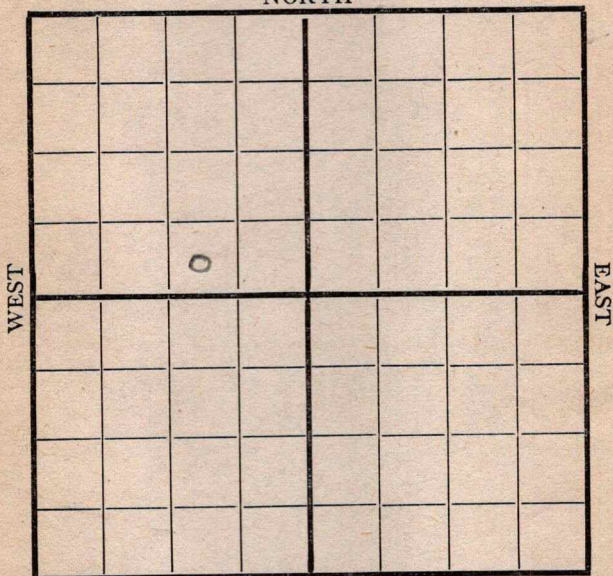

SOUTH

Location ✓ 990-E  
250-S  
 Rig up \_\_\_\_\_  
 Drilling and Remarks:

**RECORD**

Cased \_\_\_\_\_ in., \_\_\_\_\_ ft.  
 Sand \_\_\_\_\_  
 Gas \_\_\_\_\_  
 Oil \_\_\_\_\_  
 Total Depth \_\_\_\_\_

**PRODUCTION**

1st 24 hrs. Nat. \_\_\_\_\_  
 1st 24 hrs. after shot \_\_\_\_\_  
 Gas \_\_\_\_\_ Cu. Ft.  
 Dry Hole \_\_\_\_\_  
 Abandoned \_\_\_\_\_

Date

9/18 1918 Bye Scout

Map No. K14 Sec. 8 Twp. 26 R. 5Well No. 12 AndersonEmpire Company

Contractor

NORTH

WEST

EAST

SOUTH

Location ✓ 990-ERig up 250-S

Drilling and Remarks:

## RECORD

Cased \_\_\_\_\_ in., \_\_\_\_\_ ft.

Sand \_\_\_\_\_

Gas \_\_\_\_\_

Oil \_\_\_\_\_

Total Depth \_\_\_\_\_

## PRODUCTION

1st 24 hrs. Nat. \_\_\_\_\_

1st 24 hrs. after shot \_\_\_\_\_

Gas \_\_\_\_\_ Cu. Ft.

Dry Hole \_\_\_\_\_

Abandoned \_\_\_\_\_

Date

Pyle

191

Scott

WEST

# EAST

## SOUTH

**Drilling and Remarks:**

Total Depth\_\_\_\_\_

Abandoned. ✓

Date \_\_\_\_\_

10/191 Scout

Map No. K14 Sec. 8 Twp. 26 R. 5Well No. 12 AndersonEmpire Company

Contractor

NORTH

WEST

EAST

SOUTH

FIRST REPORT

Location 990-ERig up 250-S

Drilling and Remarks:

Spudding  
✓

## RECORD

Cased \_\_\_\_\_ in., \_\_\_\_\_ ft.

Sand \_\_\_\_\_

Gas \_\_\_\_\_

Oil \_\_\_\_\_

Total Depth \_\_\_\_\_

## PRODUCTION

1st 24 hrs. Nat. \_\_\_\_\_

1st 24 hrs. after shot \_\_\_\_\_

Gas \_\_\_\_\_ Cu. Ft.

Dry Hole \_\_\_\_\_

Abandoned \_\_\_\_\_

Date

10/16 1918

Pyle

Scout

Map No. K 14 Sec. 8 Twp. 26 R. 5  
 Well No. 12 Anderson  
Empire Company  
 Contractor

NORTH

WEST

EAST

SOUTH

Location 990-E  
250-S

Rig up \_\_\_\_\_

Drilling and Remarks:

10" @ 1685

O.D.

## RECORD

Cased \_\_\_\_\_ in., \_\_\_\_\_ ft.

Sand \_\_\_\_\_

Gas \_\_\_\_\_

Oil \_\_\_\_\_

Total Depth \_\_\_\_\_

## PRODUCTION

1st 24 hrs. Nat. \_\_\_\_\_

1st 24 hrs. after shot \_\_\_\_\_

Gas \_\_\_\_\_ Cu. Ft.

Dry Hole \_\_\_\_\_

Abandoned \_\_\_\_\_

Date

11/15 1918


Pyle

Scout

Map No. K14 Sec. 8 Twp. 26 R. 5Well No. 12 Anderson  
Empire Company

Contractor

NORTH

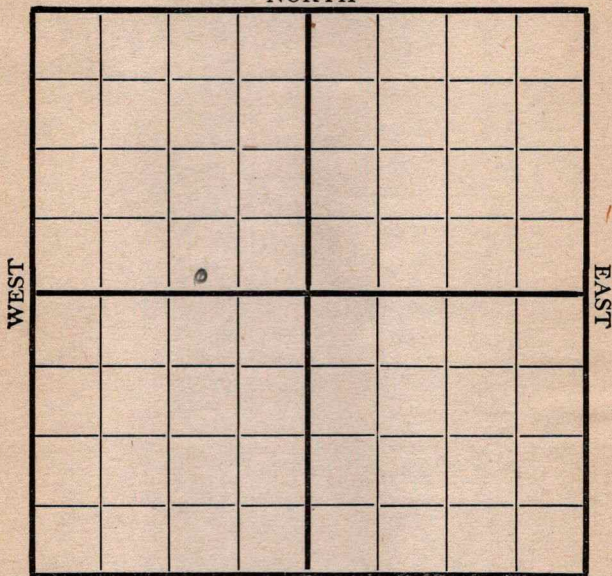

SOUTH

Location 990-ERig up 250-S

Drilling and Remarks:

10" @ 1685'

## RECORD

Cased \_\_\_\_\_ in., \_\_\_\_\_ ft.

Sand \_\_\_\_\_

Gas \_\_\_\_\_

Oil \_\_\_\_\_

Total Depth \_\_\_\_\_

## PRODUCTION

1st 24 hrs. Nat. \_\_\_\_\_

1st 24 hrs. after shot \_\_\_\_\_

Gas \_\_\_\_\_ Cu. Ft.

Dry Hole \_\_\_\_\_

Abandoned \_\_\_\_\_

Date

11/7 1918


Pyle

Scout

Map No. R14 Sec. 8 Twp. 26 R. 5  
 Well No. 12 Anderson  
Empire Company  
 Contractor

NORTH

WEST

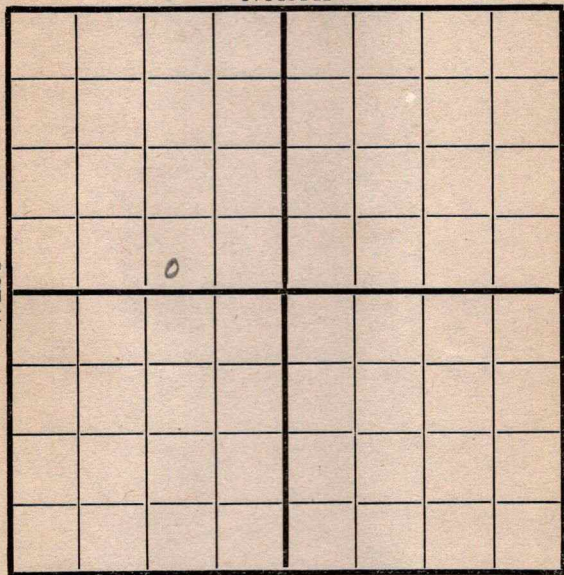

EAST

SOUTH

990-E

250-S

Location \_\_\_\_\_

Rig up \_\_\_\_\_

Drilling and Remarks:

1705'

## RECORD

Cased \_\_\_\_\_ in., \_\_\_\_\_ ft.

Sand \_\_\_\_\_

Gas \_\_\_\_\_

Oil \_\_\_\_\_

Total Depth \_\_\_\_\_

## PRODUCTION

1st 24 hrs. Nat. \_\_\_\_\_

1st 24 hrs. after shot \_\_\_\_\_

Gas \_\_\_\_\_ Cu. Ft.

Dry Hole \_\_\_\_\_

Abandoned \_\_\_\_\_

Date

11/20 1918

C. L. Scout


Map No. K 14 Sec. 8 Twp. 26 R. 5Well No. 12 AndersonCompany Empire

Contractor \_\_\_\_\_

NORTH

WEST

EAST

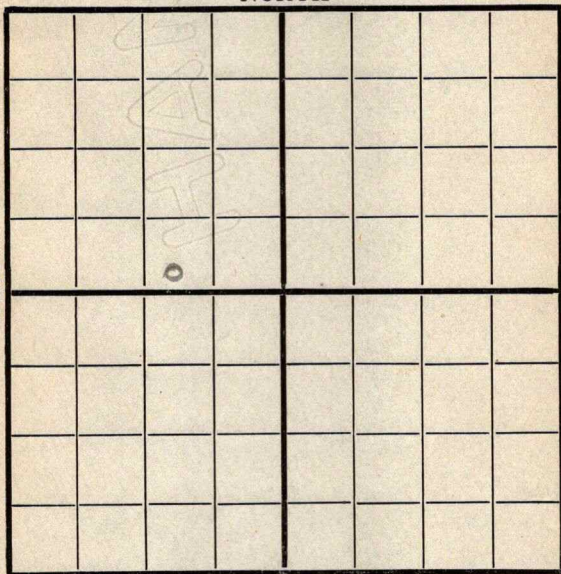

SOUTH

250-S

990 E

Location \_\_\_\_\_

Rig up \_\_\_\_\_

Drilling and Remarks:

D. H. for  
 6 5/8 @  
 2320'

## RECORD

Cased \_\_\_\_\_ in., \_\_\_\_\_ ft.

Sand \_\_\_\_\_

Gas \_\_\_\_\_

Oil \_\_\_\_\_

Total Depth \_\_\_\_\_

## PRODUCTION

1st 24 hrs. Nat. \_\_\_\_\_

1st 24 hrs. after shot \_\_\_\_\_

Gas \_\_\_\_\_ Cu. Ft.

Dry Hole \_\_\_\_\_

Abandoned \_\_\_\_\_

Date

Pyle

191

Scout


Map No. K 14 Sec. 8 Twp. 26 R. 5Well No. 12 AndersonEmpire Company

Contractor

NORTH

WEST

EAST

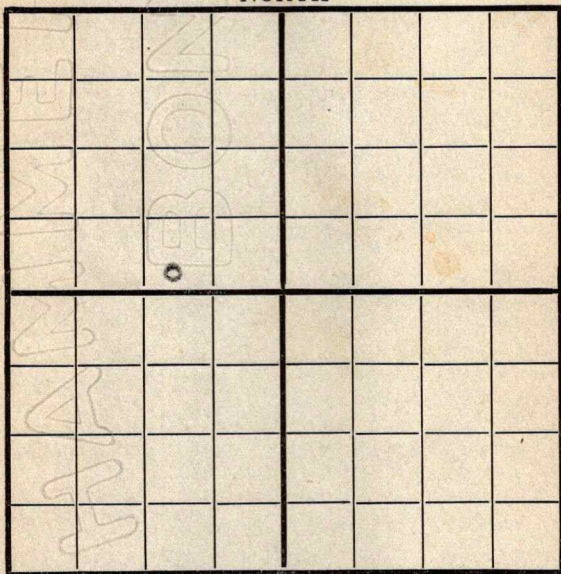

SOUTH

250-S

990 E

Location \_\_\_\_\_

Rig up \_\_\_\_\_

Drilling and Remarks:

## RECORD

Cased \_\_\_\_\_ in., \_\_\_\_\_ ft.

Sand \_\_\_\_\_

Gas \_\_\_\_\_

Oil \_\_\_\_\_

Total Depth \_\_\_\_\_

## PRODUCTION

1st 24 hrs. Nat. \_\_\_\_\_

1st 24 hrs. after shot \_\_\_\_\_

Gas \_\_\_\_\_ Cu. Ft.

Dry Hole \_\_\_\_\_

Abandoned \_\_\_\_\_

Date

12/4 1918


C. L. Scout

Map No. K14 Sec. 8 Twp. 26 R. 5  
 Well No. 12 Anderson  
Empire Company  
 Contractor

NORTH

WEST

EAST

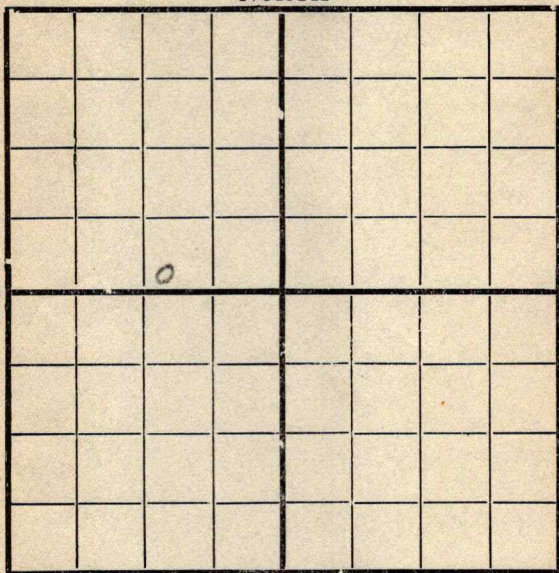

SOUTH

990-E

250-S

Location \_\_\_\_\_

Rig up \_\_\_\_\_

Drilling and Remarks:

Top D. 2406

SD for  
crew

## RECORD

Cased \_\_\_\_\_ in., \_\_\_\_\_ ft.

Sand \_\_\_\_\_

Gas \_\_\_\_\_

Oil \_\_\_\_\_

Total Depth \_\_\_\_\_

## PRODUCTION

1st 24 hrs. Nat. \_\_\_\_\_

1st 24 hrs. after shot \_\_\_\_\_

Gas \_\_\_\_\_ Cu. Ft.

Dry Hole \_\_\_\_\_

Abandoned \_\_\_\_\_

Date

12/

191

8

H. B.

Scout

Map No. K 14 Sec. 8 Twp. 26 R. 5Well No. 12 AndersonEmpire N. & F. Company

Contractor

NORTH

WEST

EAST

COMPLETED

SOUTH

990-E

250-S

Location \_\_\_\_\_

Rig up \_\_\_\_\_

Drilling and Remarks:

## RECORD

Cased \_\_\_\_\_ in., \_\_\_\_\_ ft.

Sand 2406-2448

Gas \_\_\_\_\_

Oil \_\_\_\_\_

Total Depth \_\_\_\_\_

## PRODUCTION

1st 24 hrs. Nat. 150 bbls

1st 24 hrs. after shot \_\_\_\_\_

Gas \_\_\_\_\_ Cu. Ft.

Dry Hole \_\_\_\_\_

Abandoned \_\_\_\_\_

Date

12/19191 8Chy to

Scout