


Map No. _____ Sec. 8 Twp. 26 R. 5Well No. 13 Batman Farm __________Empire_____
Company

NORTH

WEST

EAST

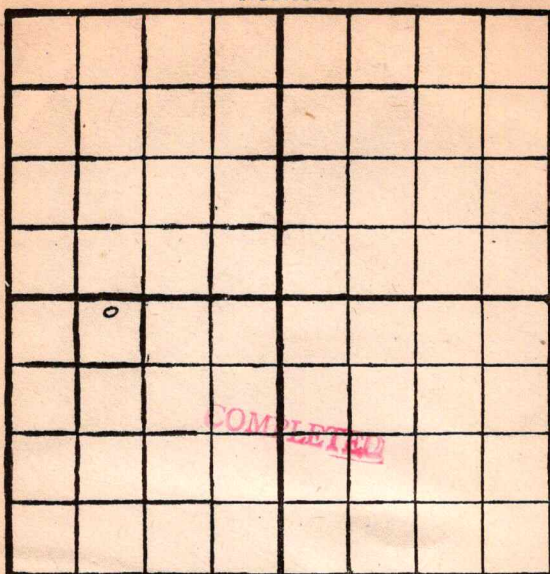

SOUTH

Location _____

Rig Up _____

Drilling Remarks:

Drilling Remarks:

RECORD

PRODUCTION

Cased _____ in. _____ ft.

1st 24 hrs. Nat. _____

Sand _____

1st 24 hrs. after shot _____

Gas _____

Gas _____ cu. ft.

Oil _____

Dry Hole _____

Total Depth _____


Abandoned _____

Map No. K 14 Sec. 8 Twp. 26 R. 5
 Well No. 13 Batman
Empire Company
 Contractor

NORTH

WEST

EAST

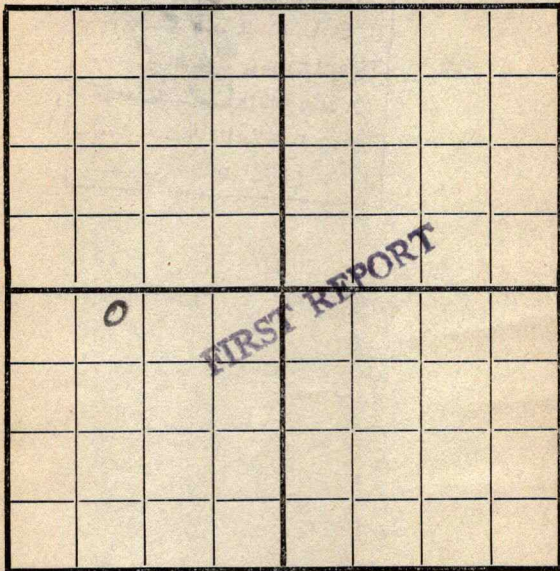

954 W SOUTH 250 N

Location _____

Rig up ☒

Drilling and Remarks:

RECORD

Cased _____ in., _____ ft.

Sand _____

Gas _____

Oil _____

Total Depth _____

PRODUCTION

1st 24 hrs. Nat. _____

1st 24 hrs. after shot _____

Gas _____ Cu. Ft.

Dry Hole _____

Abandoned _____

Date

Feb 5 1919 Gyle Scout

Map No. K14 Sec. 8 Twp. 26 R. 5Well No. 13 BatmanEmpire Company

Contractor

NORTH

WEST

EAST

SOUTH

Location _____

Rig up _____

Drilling and Remarks:

RECORD

Cased 10 in., 1500 ft.

Sand _____

Gas _____

Oil _____

Total Depth _____

PRODUCTION

1st 24 hrs. Nat. _____

1st 24 hrs. after shot _____

Gas _____ Cu. Ft.

Dry Hole _____

Abandoned _____

Date

Pyle

191

9

Scout

Map No. K14 Sec. 8 Twp. 26 R. 5Well No. 13 Batman
Ensign _____ Company _____

Contractor _____

NORTH

WEST

EAST

COMPLETED

SOUTH

954 W

250 N

Location _____

Rig up _____

Drilling and Remarks:

RECORD

Cased _____ in., _____ ft.

Sand 2415-2459

Gas _____

Oil _____

Total Depth _____

PRODUCTION

1st 24 hrs. Nat. 127 1/2 bbl

1st 24 hrs. after shot _____

Gas _____ Cu. Ft.

Dry Hole _____

Abandoned _____

Date

191

9

Scout