


Map No. _____ Sec. 8 Twp. 26 R. 5Well No. 14 Batuman _____ Farm_____Empire _____ Company

NORTH

WEST

EAST

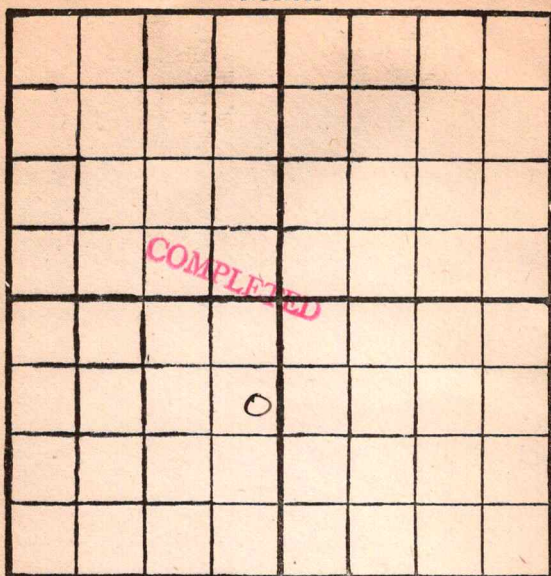

SOUTH

Location _____

Rig Up _____

Drilling Remarks:

Drilling Remarks:

RECORD

Cased _____ in. _____ ft.

Sand _____

Gas _____

Oil _____

Total Depth _____

PRODUCTION

1st 24 hrs. Nat. _____

1st 24 hrs. after shot _____

Gas _____ cu. ft.

Dry Hole _____

Abandoned _____

WEST

EAST

FIRST REPORT

SOUTH

Location _____

Rig up ✓

Drilling and Remarks:

RECORD

Cased_____in., _____ft.

Sand_____

Gas

Oil _____

Total Depth_____

PRODUCTION

1st 24 hrs. Nat. _____

1st 24 hrs. after shot-----

Gas.....Cu. Ft.

Dry Hole.....

Abandoned_____

Date _____

April 8, 1919. Gayle Scout


Map No. K14 Sec. 8 Twp. 26 R. 5Well No. 14 BatmanEmpire Company

Contractor

NORTH

WEST

EAST

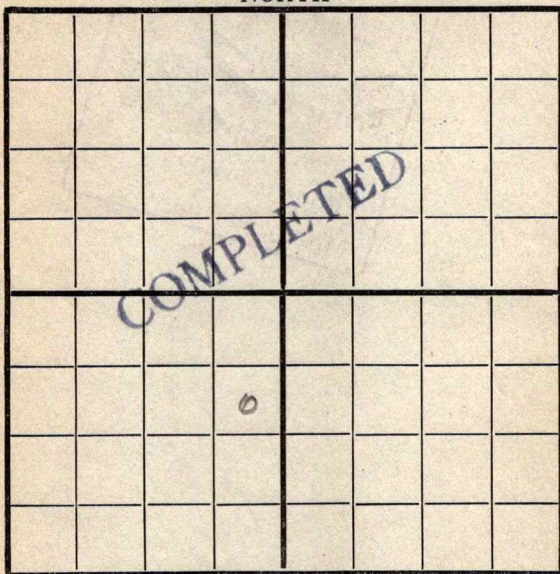

990 N

SOUTH

330 E

Location _____

Rig up _____

Drilling and Remarks:

20 bbls
5 hours

RECORD

Cased _____ in., _____ ft.

Sand 2467 - 2460

Gas _____

Oil _____

Total Depth _____

PRODUCTION

1st 24 hrs. Nat. _____

1st 24 hrs. after shot _____

Gas _____ Cu. Ft.

Dry Hole _____

Abandoned _____

Date

6/27
1919

Pyle

Scout