


Map No. _____ Sec. 8 Twp. 26 R. 5
Well No. 16 Batman Farm
Empire Company

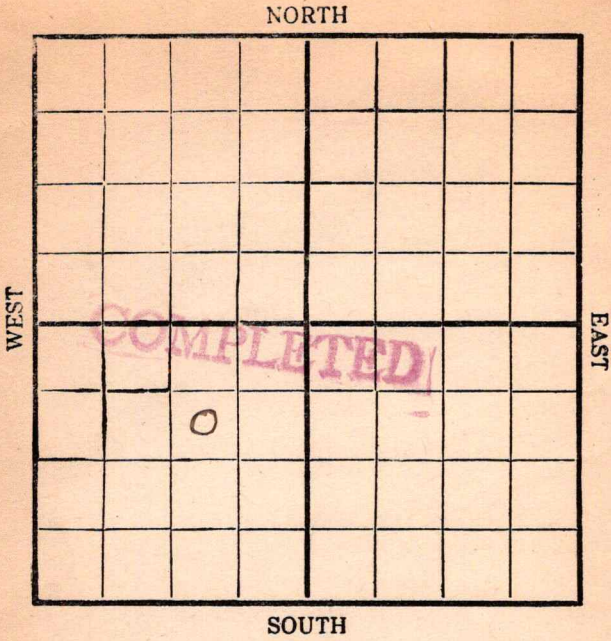

Location _____

Drilling Remarks:

Rig Up _____

Drilling Remarks:

RECORD

Cased _____ in. _____ ft.

Sand _____

Gas _____

Oil _____

Total Depth _____

PRODUCTION

1st 24 hrs. Nat. _____

1st 24 hrs. after shot _____

Gas _____ cu. ft.

Dry Hole _____

Abandoned _____

Empire G. & Co Company

4th Quarter

Ft. from W. Line


1911	Reg.
1911	24-23-77' - 3rd Bks.

COMPLETED

Map No. K14 Sec. 8 Twp. 26 R. 5
Well No. 16 Batman
Empire Company
Contractor

NORTH

WEST

EAST

FIRST REPORT

SOUTH

990 N-E

Location _____

Rig up _____

Drilling and Remarks:

RECORD

Cased _____ in., _____ ft.

Sand

Gas

0:1 _____

Total Depth_____

PRODUCTION

1st 24 hrs. Nat.

1st 24 hrs. after shot -----

Gas_____Cu. Ft.

Dry Hole_____

Abandoned.....

Date _____

6/27

191.9.

Pyle

Scott

Map No. K14 Sec. 8 Twp. 26 R. 5
Well No. 16 Batman
Empire Company
Contractor

SECTION PLAT

990 Ft. from N. Line
Ft. from S. Line
990 Ft. from E. Line
Ft. from W. Line

Location _____
Rig up _____
Drilling and Remarks:

RECORD

Cased _____ in., _____ ft.
Sand 2423-2477
Gas _____
Oil _____
Total Depth _____

PRODUCTION

1st 24 hrs. Nat. 30 bbls
1st 24 hrs. after shot _____
Gas _____ Cu. Ft.
Dry Hole _____
Abandoned _____

Date 10/27 1919 Pyle Scout