
Form 51—10M—8-19—CroMac

Map No. 5 Sec. 20 Twp. 23 R. 4

Well No. 7 Kehr Farm

Transcontinental Company

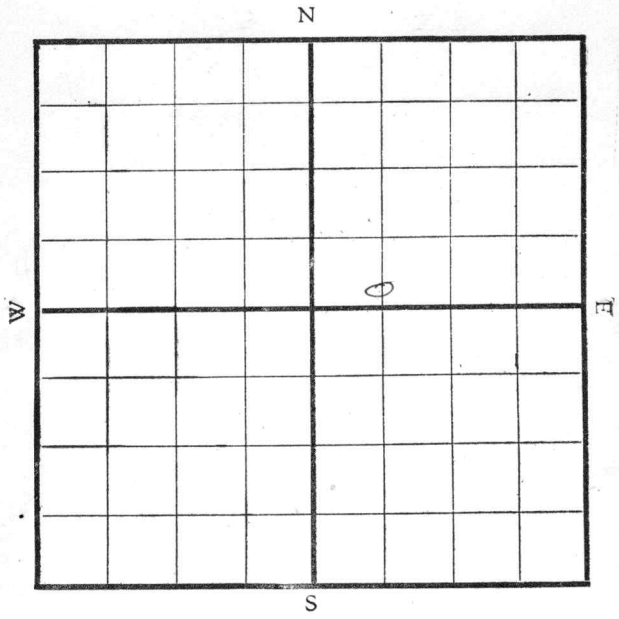

Location _____

Drilling Remarks:

Rig Up _____

Drilling Remarks:

COMPLETED

RECORD

Cased _____ in. _____ ft.

Sand _____

Gas _____

Oil _____

Total Depth _____

PRODUCTION

1st 24 hrs. Nat. _____

1st 24 hrs. after shot _____

Gas _____ cu. ft.

Dry Hole _____


Abandoned _____

Form 252A—6M-11-19-CroMac.

Map No. 5 Sec. 20 Twp. 23 R. 4

Well No. 5 ## Kehr Farm

Transcontinental Company

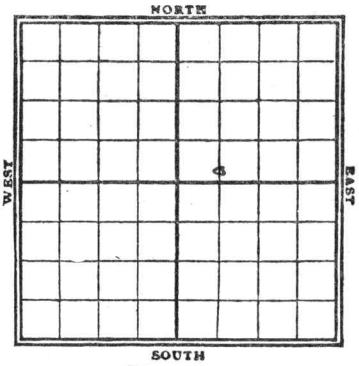

____ Ft. from N. Line

200 Ft. from S. Line

____ Ft. from E. Line

660 Ft. from W. Line

Date 1920	REPORT
1/20	Rig up.
27	Rig
3/2	"
9	Spudded.
16	Dlg 845'
23	Dlg 1450'
31	" 1795'
8	Dlg 1950
15	" 2100
26	Bay 2100'
29	& Isolo 2100'
4/30	Dlg 2260
14	Lost 2412 showings
29	SD 2412
5/3	D&A 2415

FIRST REPORT

COMPLETED

Form 26—1M—4-19—Mid-West

Map No. K14 Sec. 20 Twp. 23 R. 4

Well No. 4 Kehr

Transcontinental Oil Company

_____Contractor

SECTION PLAT



_____Ft. from N. Line

200 Ft. from S. Line

_____Ft. from E. Line

660 Ft. from W. Line

Location _____

Rig up ✓

Drilling and Remarks:

RECORD

Cased _____in., _____ft.

Sand _____

Gas _____

Oil _____

Total Depth _____

PRODUCTION

1st 24 hrs. Nat. _____

1st 24 hrs. after shot _____

Gas _____Cu. Ft.

Dry Hole _____

Abandoned _____

Date

1/20/1920

Pyle Scout

Form 26—1M—4-19—Mid-West


Map No. K14 Sec. 20 Twp. 23 R. 4

Well No. 5 Kehr

Transcontinental Company

Contractor

SECTION PLAT

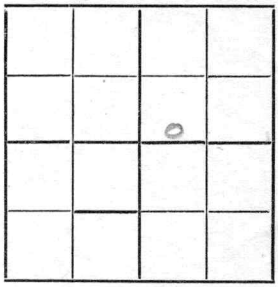

Ft. from N. Line

200 Ft. from S. Line

Ft. from E. Line

660 Ft. from W. Line

Location

Rig up

Drilling and Remarks:

Change No from 4

RECORD

Cased in., ft.

Sand

Gas

Oil

Total Depth

PRODUCTION

1st 24 hrs. Nat.

1st 24 hrs. after shot

Gas Cu. Ft.

Dry Hole

Abandoned

Date 2/9 1920

Pyle Scout

Butler

FORM 26-250 BKS. 4-28 WESTERN

K14 KANSAS SEC. 20 TWP. 23S R. 4E




CONTRACTOR

ABANDONED

SECTION PLAT

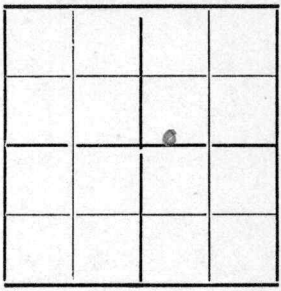

____ FT. FROM N. LINE

____ FT. FROM S. LINE

____ FT. FROM E. LINE

____ FT. FROM W. LINE

LOCATION

RIG UP

DRILLING AND REMARKS:

RECORD

CASED ____ IN., ____ FT.

SAND

GAS

OIL

TOTAL DEPTH 2415

PRODUCTION

1ST 24 HRS. NAT.

1ST 24 HRS. AFTER SHOT

GAS ____ CU. FT.

DRY HOLE

ABANDONED

DATE 4/27 1920 SCOUT

Form 26—1M—4-19—Mid-West

Map No. K 14 Sec. 20 Twp. 23 R. 4

Well No. 5 Kehn

Transcontinental Company

Contractor

SECTION PLAT



Ft. from N. Line

300 Ft. from S. Line

Ft. from E. Line

660 Ft. from W. Line

COMPLETED

Location

Rig up

Drilling and Remarks:

RECORD

Cased in., ft.

Sand

Gas

Oil

Total Depth

PRODUCTION

1st 24 hrs. Nat.

1st 24 hrs. after shot

Gas Cu. Ft.

Dry Hole 2415

Abandoned

Date

5/13 191

Pyle Scout