


Section 8 Township 26 Range 5-EWell No. #1 BoyerCompany E. Adair
Miscellaneous Pool

NORTH

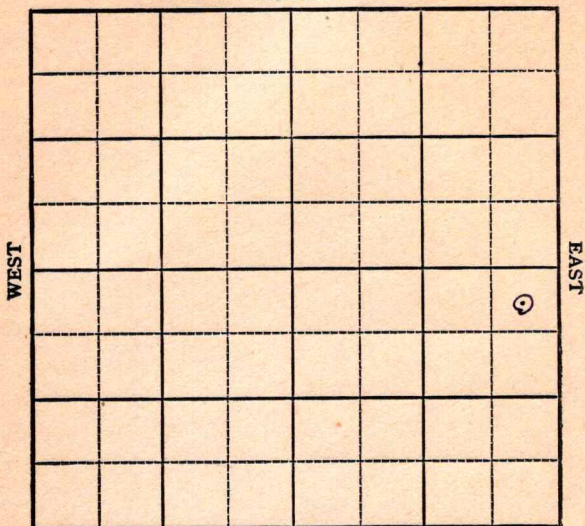

SOUTH

Sec. 8 Twp. 26 R. 5-EWell No. #1 Boyer FarmE Adair Company

Miscellaneous


330 Ft. from N. Line

Ft. from S. Line

330 Ft. from E. Line

Ft. from W. Line

NE SE

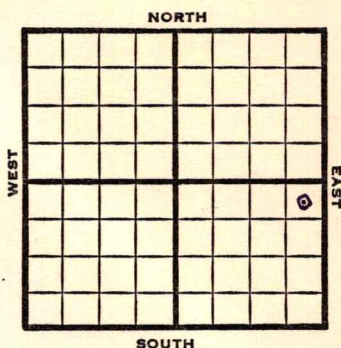

1948 Elev. 1357' REPORT

0/13 Location

10/19 Mach.

10/26 15" @ 140'

Drlg. 800'

11/3 13" @ 835'

10" @ 1450' CO

11/10 10" @ 1450'

Lansing 1690'

KC 1985'

9" @ 2252'

Drlg 2355'

11/16 Arbuckle 2450'

TD 2492'

5" @ 2439'

11/23 TD 2494'

100 qts 2455'-94'

CO

11/30 "

12/6 "

12/14 "

12/22 Arb 2450'

5" @ 2439'

Pump 25 oil & 50 W Pot.

Gr. 38°

TD 3494'

COMPLETED

Map No. _____ Sec. 8 Twp. 26 R. 5EWell No. 1 BoyerE. Adair CompanyFIRST REPORT Contractor

NE SE


SECTION PLAT

330 Ft. from N. Line

_____ Ft. from S. Line

330 Ft. from E. Line

_____ Ft. from W. Line

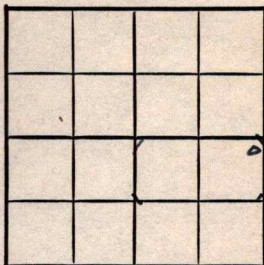Butler CountyLocation

Rig up _____

Drilling and Remarks:

RECORD

Cased _____ in., _____ ft.

Sand _____

Gas _____

Oil _____

Total Depth _____

PRODUCTION

1st 24 hrs. Nat. _____

1st 24 hrs. after shot _____

Gas _____ Cu. Ft.

Dry Hole _____

Abandoned _____

Date

OCT 13 1948 19S. J. LEWIS Scout

Map No. 14 Sec. 8 Twp. 26 R. 5EWell No. 1 BoyerE. Adair Company

COMPLETE

Contractor

NE SE

SECTION PLAT

330 Ft. from N. Line Ft. from S. Line330 Ft. from E. Line Ft. from W. Line

Butler County

			8

Location Rig up

Drilling and Remarks:

*Cr 2450**5" @ 2439**Prod 25 oil + 50 water**Box**25 @ 24*

RECORD

Cased in., ft.Sand Gas Oil ☒ Total Depth 2484

PRODUCTION

1st 24 hrs. Nat. 1st 24 hrs. after shot Gas Cu. Ft.Dry Hole Abandoned

Date

DEC 22 1948 19S. J. LEWIS

Scout