


Map No. _____ Sec. 8 Twp. 26 R. 5
 Well No. #10 Boyer Farm _____
Empire Company

NORTH

WEST

EAST

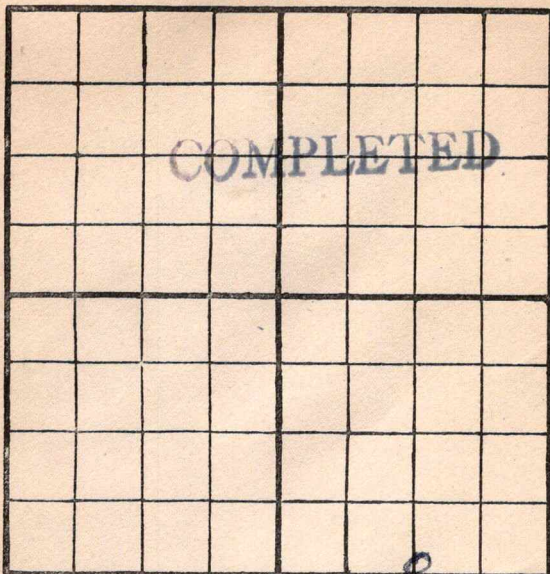

SOUTH

Location _____

Rig Up _____

Drilling Remarks:

Drilling Remarks:

RECORD

Cased _____ in. _____ ft.

Sand _____

Gas _____

Oil _____

Total Depth _____

PRODUCTION

1st 24 hrs. Nat. _____

1st 24 hrs. after shot _____

Gas _____ cu. ft

Dry Hole _____

Abandoned _____

Map No. _____ Sec. 8 Twp. 26 R. 5
 Well No. 10 Boyer Farm _____
 _____ Emp. Company _____

NORTH

SOUTH

WEST

EAST

NEW LOCATION

0

Location _____
 Rig up ✓
 Drilling and remarks:

RECORD	
Cased _____	in. _____ Ft.
Sand _____	
Gas _____	
Oil _____	
Total Depth _____	
PRODUCTION	
1st 24 hrs. Nat. _____	
1st 24 hrs. after shot _____	
Gas _____	Cu. Ft. _____
Dry Hole _____	
Abandoned _____	

Date JUN 30 1917
 _____, 191____ C. J. Cook Scout

Map No. _____ Sec. 8 Twp. 26 R. 5
 Well No. 10 Boyer Farm _____
 _____ Emp. Company

NORTH

WEST

EAST

SOUTH

Location _____

Rig up _____

Drilling and remarks:

*Fishing for
Tools 270'*

RECORD

Cased _____ in. _____ Ft.

Sand _____

Gas _____

Oil _____

Total Depth _____

PRODUCTION

1st 24 hrs. Nat. _____

1st 24 hrs. after shot _____

Gas _____ Cu. Ft.


Dry Hole _____

Abandoned _____

Date

JUL 7 1917, E. J. Crocker Scout

Map No. _____ Sec. 8 Twp. 26 R. 5
 Well No. 10 Boyer Farm
Emp Company

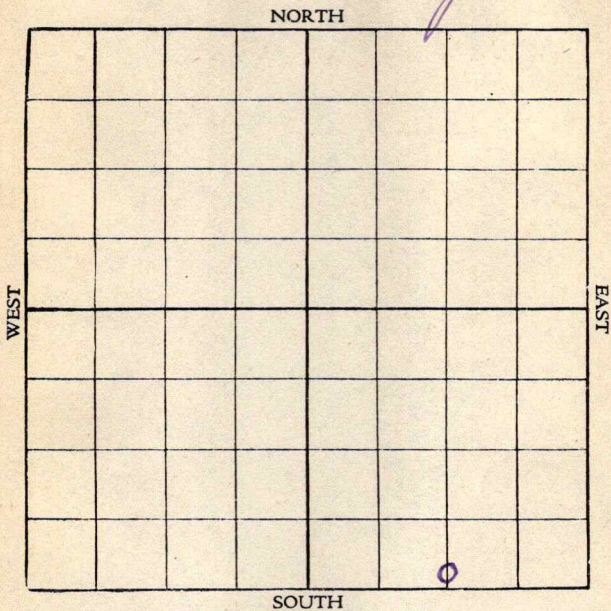

Location _____
 Rig up _____
 Drilling and remarks:

St. Paul 640'

RECORD

Cased _____ in. _____ Ft.
 Sand _____
 Gas _____
 Oil _____
 Total Depth _____

PRODUCTION

1st 24 hrs. Nat. _____
 1st 24 hrs. after shot _____
 Gas _____ Cu. Ft.
 Dry Hole _____
 Abandoned _____

Date

JUL 14 1917, 1917, G. T. Crocker Scout

Map No. _____ Sec. 8 Twp. 26 R. 5Well No. 10 Boyer Farm _____

Company _____

NORTH

WEST

EAST

SOUTH

Location _____

Rig up. ☒ _____

Drilling and remarks:

RECORD

Cased _____ in. _____ Ft.

Sand _____

Gas _____

Oil _____

Total Depth _____

PRODUCTION

1st 24 hrs. Nat. _____

1st 24 hrs. after shot _____

Gas _____ Cu. Ft.

Dry Hole _____

Abandoned _____

Date

, 191

Scout

W LOCATION


NEW LOCATION

Map No. _____ Sec. 8 Twp. 26 R. 5Well No. 10 Boyer Farm _____
Empire Company

NORTH

WEST

EAST

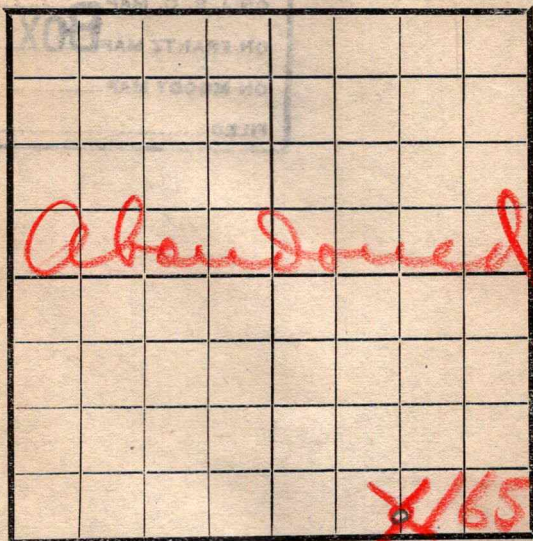

SOUTH

Location _____

Rig Up _____

Drilling and remarks

This was drilled for a shallow well and came in dry & Abandoned

RECORD

Cased _____ in _____ Ft

Sand _____

Gas _____

Oil _____

Total Depth _____

PRODUCTION

1st 24 hrs. Nat. _____

1st 24 hrs. after shot _____

Gas _____ Cu. Ft

Dry Hole _____

Abandoned _____

Date

Aug, 1917 Conley Scout _____