


Butler Co

Map No. Kansas Sec. 20 Twp. 23 R. 4

Well No. 12 Paris (Parris) Farm

Arkansas River Gas Company

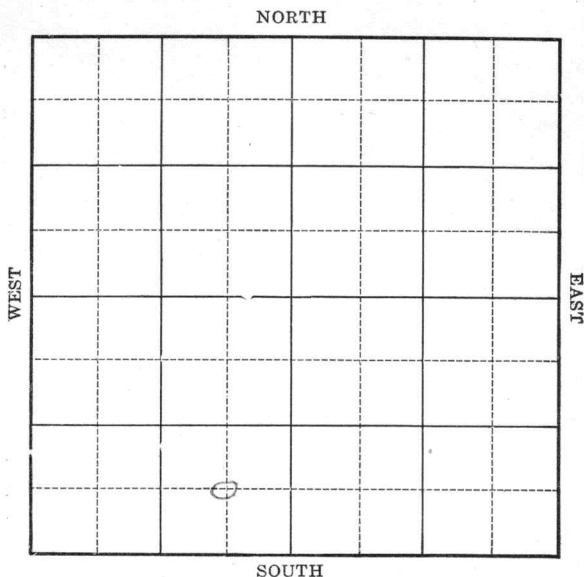

Location _____

Drilling Remarks

RECORD

Cased _____ in. _____ ft.
 Sand _____
 Gas _____
 Oil _____
 Total Depth _____

Rig Up _____

Drilling Remarks

PRODUCTION


1st 24 hrs. Nat. _____
 1st 24 hrs. after shot _____
 Gas _____ cu. ft.
 Dry Hole _____
 Abandoned _____

Map No. _____ Sec. 20 Twp. 23 R. 4Well No. 12 Paris Farm _____
Arkansas River Gas Company

_____ Ft. from N. Line

660 Ft. from S. Line660 Ft. from E. Line

_____ Ft. from W. Line

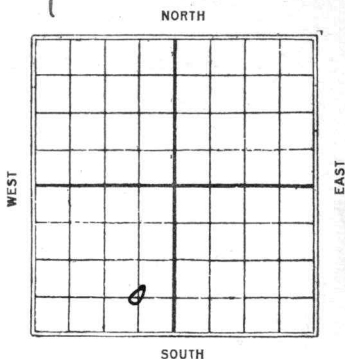1926

Date	REPORT
<u>2/10</u>	<u>Drly. 1000'</u>
<u>2/17</u>	<u>Collapsed.</u>
<u>2/24</u>	_____
<u>3/5</u>	_____
<u>3/10</u>	_____
<u>3/18</u>	_____
<u>3/25</u>	_____
<u>4/1</u>	_____
<u>4/7</u>	_____
<u>4/14</u>	<u>Drly 635'</u>
<u>4/21</u>	_____
<u>4/30</u>	_____
<u>5/8</u>	<u>J.O. 2114. Skid rig</u>
<u>5/12</u>	<u>Same.</u>
<u>5/19</u>	<u>Rig</u>
<u>6/2</u>	_____
<u>6/10</u>	<u>dry sand 2071-2104'</u> <u>sdys shale 2104-08 oil 2108</u> <u>to 12' water 2112-14'</u> <u>est. 10 bbls, may drill deeper</u>
<u>6/17</u>	<u>sand 2071-2112 T.D. 2114</u> <u>- 10 bbls</u>

MAP NO. K14 KANSAS SEC. 20 TWP. 23S R. 4E

WELL NO. 12 Panjo

Ark. River Gas COMPANY

CONTRACTOR

SECTION PLAT

ABANDONED

_____ FT. FROM N. LINE

_____ FT. FROM S. LINE

_____ FT. FROM E. LINE

_____ FT. FROM W. LINE

RECORD

LOCATION _____

CASED _____ IN. _____ FT.

RIG UP _____

SAND _____

DRILLING AND REMARKS:

GAS _____

OIL _____

TOTAL DEPTH 2114

PRODUCTION

1ST 24 HRS. NAT. _____

1ST 24 HRS. AFTER SHOT _____

GAS _____ Cu. Ft.

DRY HOLE _____

ABANDONED _____

DATE

5/6 1926 SCOUT

Butler
 K14 KANSAS Sec. *20* Twp. *23* R. *4*
 Map No. _____
 Well No. *12* *Texas* _____
Wilson Bros *Rever* *Gas Co.* Company

Contractor _____

COMPLETED

_____ Ft. from N. Line

660 _____ Ft. from S. Line

660 _____ Ft. from E. Line

_____ Ft. from W. Line

SECTION PLAT

Location _____

Rig up _____

Drilling and Remarks:

10 BS Natural.

RECORD

Cased _____ in., _____ ft.

Sand *2071-* *2112*

Gas _____

Oil _____

Total Depth *2114*

PRODUCTION

1st 24 hrs. Nat. _____

1st 24 hrs. after shot _____

Gas _____ Cu. Ft.

Dry Hole _____

Abandoned _____

Date

JUN 17 1926

192

CHAS. L. SHERWOOD

Scout